

WATER SERVICE RECORD

Name DeVries Const. Co.

Service No. 137

Address 9 Bryant Road

Location

~~Repair~~ ~~Renewal~~ New Service

Comm 8-22-60


Date	Material	Amount	Total	Date	Amount
10-2-59	Labor	1 85		7-31-60	30 00
	10% O. H.	19	2 04	8-22-60	81
	Owner's copper 11' out				30 81
					<u>NON CHARGE</u>
7-25-60	Labor	1 94		10-2-59	1 85
	10% O.H.	19	2 13	1	3/4" C Corp Cock 4 64
	43' 3/4" Copper tubing @ .42		18 06	1	3/4" C Curb Cock 5 94
	1 3/4 Cx _W I.W.H. Stop & Waste		6 17	1	Box & Rod 5 00
	1 3/4" C3 Part Union		2 41		17 43
			30 81	1	1/2 Straight Tailpiece .50
				1	1/2 Offset tailpiece .50
					18.43

DATE _____

TOWN OF LEXINGTON — BOARD OF PUBLIC WORKS

WATER DIVISION

Sketch of Service Here

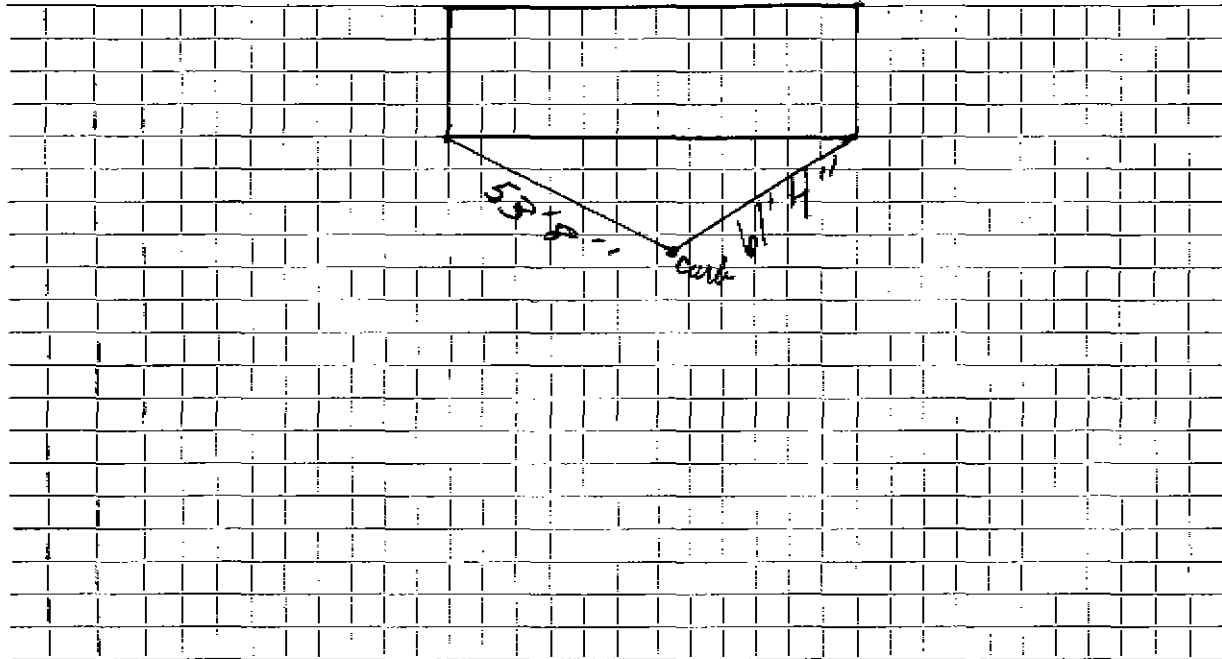

Connection made in Street. Work completed

Remarks:

.....

.....