

WATER SERVICE RECORD

Name Erwin A. Dennis

Service No. 163

Address 12 Buckman Drive

R25101

Location Lexington, Mass.


~~Repair~~ New Service *Com 10-1-51*

Date	Material	Amount	Total	Date	Amount
8/6/51	Labor	2 76	2 76	7-18-51	Deposited 50 00
	10% overhead		28	10-1-51	Refunded 2 91
	50' -3/4" copper tubing @ .326	16 30			No Charge 47 09
	1 -3/4" ex 1/2 I.W.H. stop&waste	4 00	8/6/51	Labor	8 28
	2 hrs. Littlefield shovel	14 00	14' -3/4" copper tubing @ .326		4 56
	1 hr. trucking	75	1 -3/4" C. corp-cock		4 33
	patching 9 x 3	9 00	1 -3/4" C x 3/4" C. curb-cock		4 67
		47 09	1 box and rod		4 68
			1 -1/2 offset tail piece		50
			1 1/2 straight tail piece		50
			1 hr. Littlefield shovel		7 00
			1 hr. trucking		75
					35 27

DATE _____

TOWN OF LEXINGTON — BOARD OF PUBLIC WORKS
WATER DIVISION

Sketch of Service Here

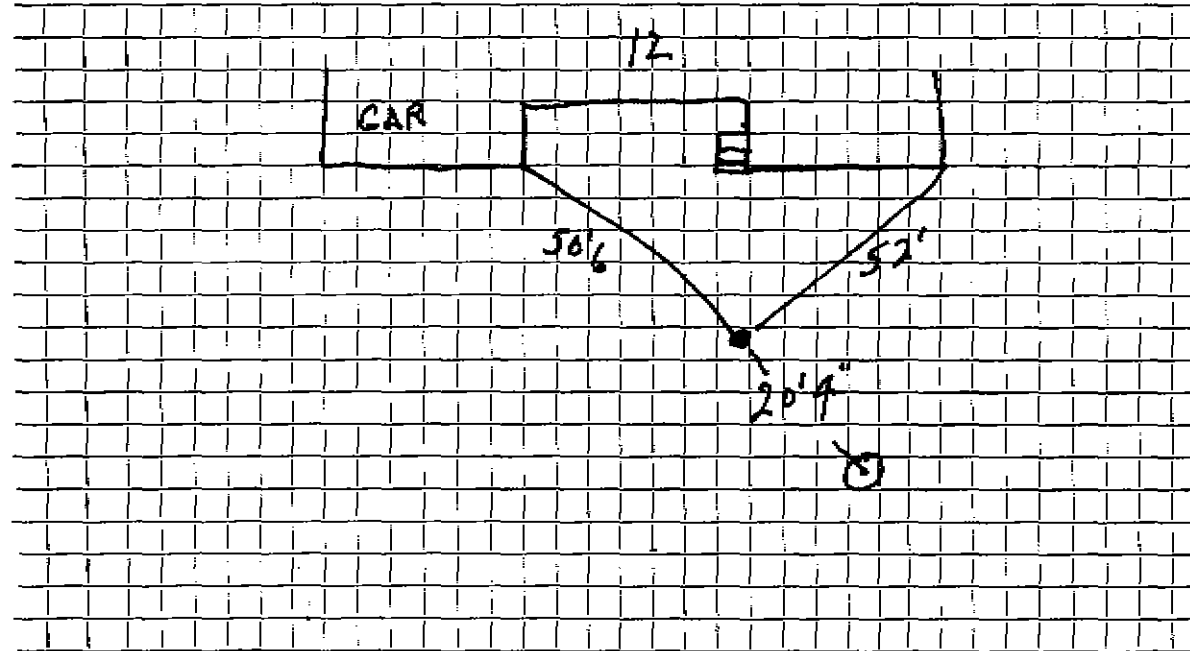

Connection made in _____ Street. Work completed _____

Remarks: _____
