

Name Edward J. Courtois

Service No. 519

Address 16 Buckman Drive

Lexington, Mass.

Location 16 Buckman Drive

1925-1926

Kind of Pipe

Size

Size of Main

~~Repair or Renewal~~ - New Service

Com. 11-8-49

Location

Date

Material

Amount

Total

Date

Amount

Oct. 18, '49

Labor

1 30

1 30

Oct 14 '49

Deposited

20 00

10% Overhead

13

Nov. 25 '49

Paid.

2 96

52' - 3/4" Copper Tubing @.24

12 48

No Charge

22 95

1 - 3/4" C x 1/2" I.W.H. S&W

3 29

Oct. 18, '49 Labor

13 70

Trucking 1 hr. @.75

75

12' - 3/4" Copper Tubing @.24

2 88

Patching 5 x 3

5 00

1 - 3/4" C Corp-cock

3 15

22 95

1 - 3/4" C x 3/4" C Curb-cock

3 85

1 - Box & Rod

3 75

1 - 1/2" Offset Tail Piece

37

1 - 1/2" Straight Tail Piece

37

Littlefield Shovel 4 hrs. @7.00

28 00

Trucking 1 hr. @.75

75

Red ink 15.00

Labor

56 82

DATE _____

TOWN OF LEXINGTON - BOARD OF PUBLIC WORKS

WATER DIVISION

The undersigned applies for a supply of water at No..... St. and hereby agrees to comply with the rules and regulations as now, or at any future time, established by the Board of Selectmen.

Am't of Estimate \$.....


Owner

Am't Paid \$.....

Address

Builder

Sketch of Service Here

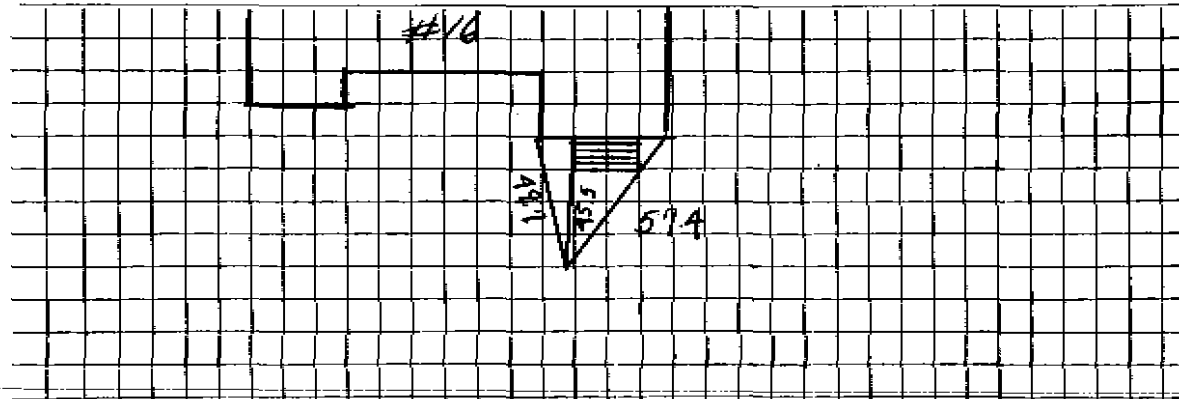

Connection made in Street.

Work completed19

Remarks: