



TOWN OF LEXINGTON – BOARD OF PUBLIC WORKS

**WATER DIVISION**

The undersigned applies for a supply of water at No..... St. and hereby agrees to comply with the rules and regulations as now, or at any future time, established by the Board of Selectmen.

Am't of Estimate \$.....


Owner .....

Am't Paid \$.....

Address .....

Builder .....

Sketch of Service Here

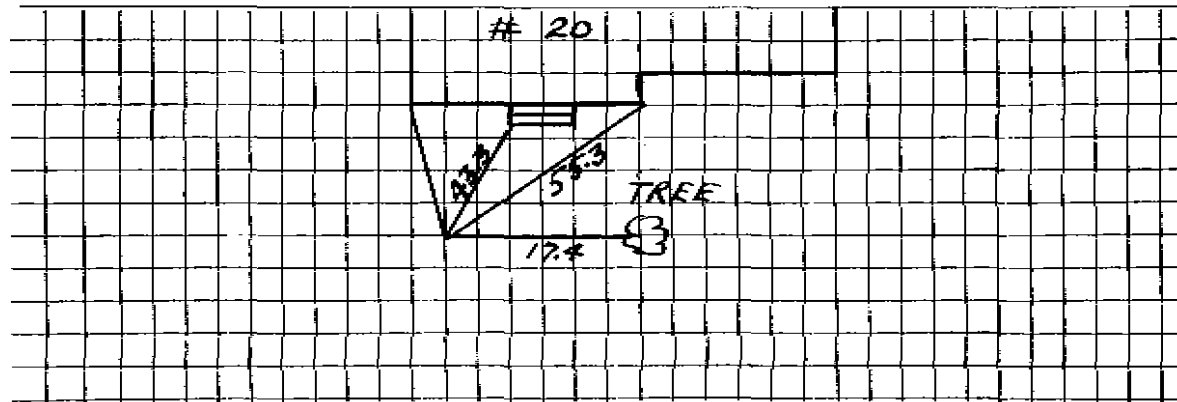

Connection made in ..... Street.

Work completed .....19

Remarks: