

Name George Cooper  
 Address 21 Buckman Drive  
 Lexington, Mass.

Service No. 68 3169  
 #4304

Location 21 Buckman Drive

Kind of Pipe

Size

Size of Main

~~Repair~~ ~~Renewal~~ - New Service

Location

Date	Material	Amount	Total	Date	Amount
Aug. 24, '46	Labor	7 77		Aug 6. '46	76 00
Aug. 26, '46	"	7 70	15 47	Nov. 29 '46	17 45
	10% Overhead		1 55		65 35
	65' - 3/4" Copper tubing @ .1911		12 48	6-14-28-46 Labor	9 63
	1 - 3/4" C x 1/2" I.W.H. S & W		3 82	30' - 3/4" Copper tubing @ .1911	3 82
	1 - 3/4" C x 3/4" C. Union (2 parts)		1 64	1 - 3/4" C. Corp-cock	2 70
	Gas Shovel 3 hrs. @ 17.00		14 00	1 - 3/4" C x 1/2" C Corp-cock	3 20
	Sullazer 3 hrs.		7 50	1 - Box & Rod	1 65
	Trucking 1 hr. @ .75		75	1 - 3/4" Offset Tail Piece	90
			55 55	1 - 3/4" Straight Tail Piece	90
				Trucking 1 hr. @ .75	75
	Labor				23 65

*Deposited*  
*Refunded*  
 Non-Charge

Hadley Press, Inc., Lexington

DATE \_\_\_\_\_

# TOWN OF LEXINGTON - BOARD OF PUBLIC WORKS

## WATER DIVISION

The undersigned applies for a supply of water at No. \_\_\_\_\_ St. and hereby agrees to comply with the rules and regulations as now, or at any future time, established by the Board of Selectmen.


Am't. of Estimate \$ \_\_\_\_\_

Owner \_\_\_\_\_

Am't. Paid \$ \_\_\_\_\_

Address \_\_\_\_\_

Builder \_\_\_\_\_

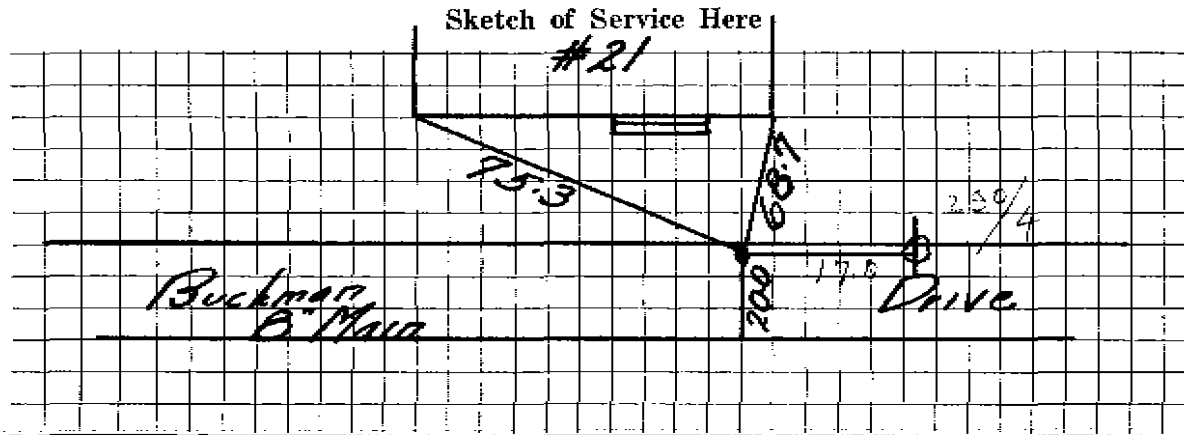

Connection made in \_\_\_\_\_ Street.

Work completed \_\_\_\_\_ 19

Remarks: