

Name Nathaniel A. Colbert

Service No. 200

Address 24 Buckman Drive

Lexington, Mass.

Location 24 Buckman Drive

Kind of Pipe

Size

Size of Main

~~Repair~~ ~~Renewal~~ New Service

Com. 11-6-50

Location

Date

Material

Amount

Total

Date

Amount

Date	Material	Amount	Total	Date	Amount	
Aug. 18, '50	Labor	2 50	2 50	Aug 18 50	67 05	
	10% Overhead		25	16 10	2 3	
	15' - 3/4" Copper Tubing @.275		12 38		52 17	
	1 - 3/4" C x 1/2" I. W. H. S&W		3 29	Aug. 19, '50	Labor	7 65
	Littlefield Shovel 3 hrs. @7.00		21 00	17' - 3/4" Copper Tubing @.275	4 68	
	Trucking 1 hr. @.75		75	1 - 3/4" C Corp-cock	3 15	
	Patching 12 x 3		12 00	1 - 3/4" C x 3/4" C Curb-cock	3 85	
			52 17	1 - Box & Rod	3 35	
				1 - 1/2" Offset Tail Piece	42	
				1 - 1/2" Straight Tail Piece	42	
				Littlefield Shovel 2 hrs. @7.00	14 00	
				Trucking 1 hr. @.75	75	
	Labor				38 27	

DATE _____

TOWN OF LEXINGTON—BOARD OF PUBLIC WORKS

WATER DIVISION

The undersigned applies for a supply of water at No. _____ St. and hereby agrees to comply with the rules and regulations as now, or at any future time, established by the Board of Selectmen.

Am't. of Estimate \$ _____


Owner _____

Am't. Paid \$ _____

Address _____

Builder _____

Sketch of Service Here

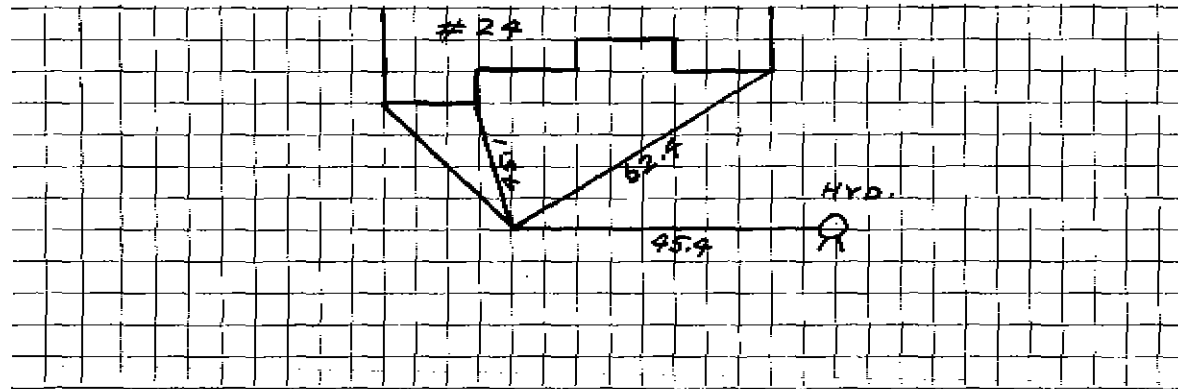

Connection made in _____ Street.

Work completed _____ 19

Remarks: