

WATER SERVICE RECORD

Name A. J. Comeau

Service No. 68

Address 35 Buckman Drive

3097

Location Lexington

Repair ~~Renewal~~ - New Service *Com. 6-16-52*


Date	Material	Amount	Total	Date	Amount
4/22/52	Labor	6 01		4-22-52	65. -
	10% Overhead	60	6 61	6-16-52	(12 14)
	48' -3/4" Cooper tubing @.3439	16 50			NON CHARGE
	1 -3/4" C x 1/2 I.W.H. Stop & Waste	4 00		4/22/52	Labor
	2 hrs/ Town Shovel @5.00	10 00			15 00
	1 hr. trucking		75	27' -3/4" Cooper Tubing C.3439	9 28
	Patching 15 x 3		15 00	1 -3/4" Corp.-Cock	4 33
			52 86	1 -3/4" C. Curb-cock	4 67
				1 - box & rod	4 52
				1 -1/2 offset tail piece	50
				1 -1/2 straight tail piece	50
				1 hr. town shovel @5.00	5 00
				1 hr. trucking	75
					144 55

DATE \_\_\_\_\_

TOWN OF LEXINGTON — BOARD OF PUBLIC WORKS

**WATER DIVISION**

Sketch of Service Here

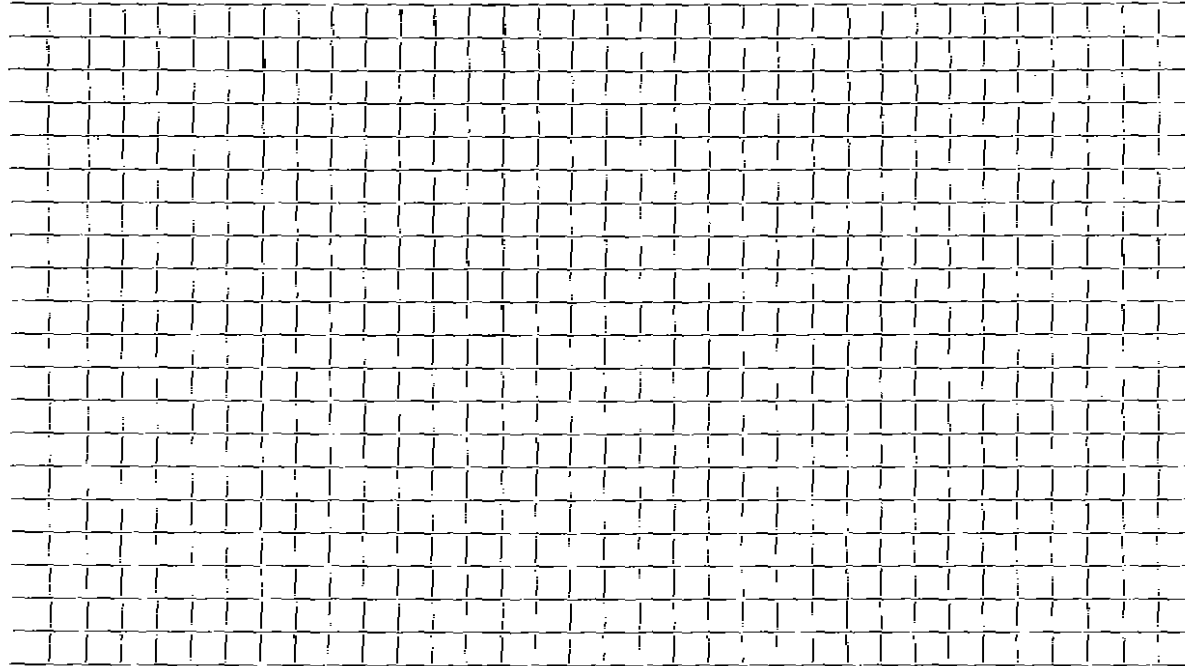

Connection made in ..... Street. .... Work completed .....

Remarks: .....

.....

.....