

Name Carl Swanson

Service No. 64

Address 39 Buckman Drive

Lexington, Mass.

Location 39 Buckman Drive

Kind of Pipe

Size

Size of Main

~~Repair & Renewal~~ - New Service

Com. 5-29-50

Location

Date	Material	Amount	Total	Date	Amount
May 5, '50	Labor	3 60	3 60	<i>April 22 '50</i>	<i>Depleted</i> 25 00
	10% Overhead		36	<i>June 1 '50</i>	<i>Refunded</i> 18 96
	55' - 3/4" Copper Tubing @.23	12 65			60 04
	1 - 3/4" C x 1/2" I.W.H. S&W	3 29		May 5, '50	Labor 3 60
	1 - 3/4" C x 3/4" C Union (3pts)	1 39		23' - 3/4" Copper Tubing @.23	5 29
	Littlefield Shovel 3 hrs. @ 7.00	21 00		1 - 3/4" C Corp-cock	3 15
	Trucking 1 hr. @.75	75		1 - 3/4" C x 3/4" C curb-cock	3 85
	Patching 17 x 3		17 00	1 - Box & Rod	3 60
			60 04	1 - 1/2" Offset Tail Piece	38
				1 - 1/2" Straight Tail Piece	38
				Littlefield Shovel 2 hrs. @7.00	14 00
				Trucking 1 hr. @.75	75
	Labor				<u>35 00</u>

TOWN OF LEXINGTON – BOARD OF PUBLIC WORKS

**WATER DIVISION**

The undersigned applies for a supply of water at No..... St. and hereby agrees to comply with the rules and regulations as now, or at any future time, established by the Board of Selectmen.

Am't of Estimate \$.....

Owner .....


Am't Paid \$.....

Address .....

Builder .....

.....

Sketch of Service Here

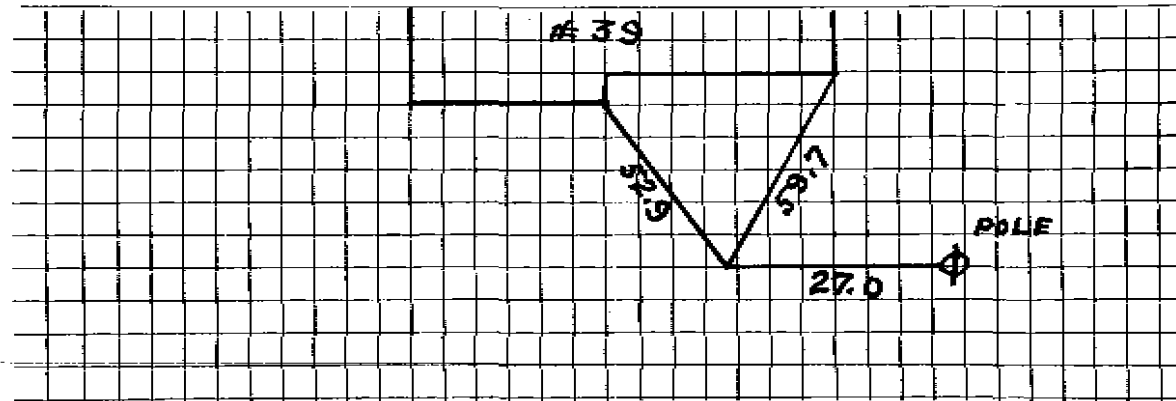

Connection made in ..... Street.

Work completed .....19

Remarks: