

Name Stanley Plalen

Service No.

53 #814

Address 42 Buckman Drive

3092

Lexington, Mass.

Location 42 Buckman Drive

Kind of Pipe

Size

Size of Main

~~Maple Street~~ New Service

Com. 6-14-49

Location

Date	Material	Amount	Total	Date	Location	Amount
Apr. 18, '49	Labor	1 25	1 25	April 15 '49	Depleted	25 00
	10% Overhead		13	June 24 '49	Refunded	2 23
	48' - 3/4" Copper Tubing @.27	12 96	12 96		Non-Charge	22 77
	1 - 3/4" C x 1/2" I.W.H. S&W	3 29	3 29	Apr. 18, '49	Labor	5 75
	1 - 3/4" C x 3/4" C Union (pts)	1 39	1 39		10' - 3/4" Copper Tubing @.27	2 70
	Trucking 1 hr. @.75	.75	.75		1 - 3/4" C Corp-cock	3 15
	Patching 3 x 3	3 00	3 00		1 - 3/4" C x 3/4" C Curb-cock	3 85
			22 77		1 - Box & Rod	3 95
					Littlefield Shovel 2 hrs. @7.00	14 00
					1 - 1/2" Offset Tail Piece	30
					1 - 1/2" Straight Tail Piece	30
					Trucking 1 hr. @.75	75
	Labor					34 89

TOWN OF LEXINGTON - BOARD OF PUBLIC WORKS

WATER DIVISION

The undersigned applies for a supply of water at No..... St. and hereby agrees to comply with the rules and regulations as now, or at any future time, established by the Board of Selectmen.

Am't of Estimate \$.....

Owner


Am't Paid \$.....

Address

Builder

.....

Sketch of Service Here

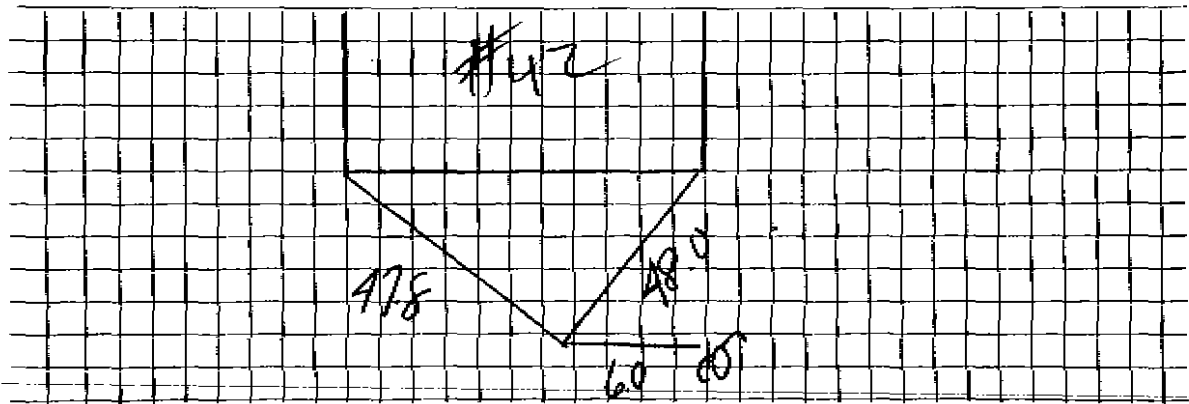

Connection made in Street.

Work completed19

Remarks: