

Name E. Tobinson  
 Address 43 Buckman Drive  
 Lexington, Mass.

Service No.

#4681

Location 43 Buckman Drive

Kind of Pipe

Size

Size of Main

~~Repair~~ ~~Renewal~~ New Service

Com. 8-23-48

Location

Date	Material	Amount	Total	Date	Amount
Jul. 6, '48	Labor	2 10		July 1, '48	25 00
7	"	3 25	5 35	July 20, '48	10 91
	10% Overhead		32		64 09
	60' - 3/4" Copper Tubing @ .255	15 30		Jul. 7, '48	3 25
	1 - 3/4" C x 1/2" I.D.H. S & C	3 15		27' - 3/4" Copper Tubing @ .255	6 89
	Littlefield Shovel 3 hrs. @ 7.00	21 00		1 - 3/4" C Corp-cock	3 00
	Trucking 1 hr. @ .75	75		1 - 3/4" C x 3/2" C Curb-cock	3 58
	Patching 18 x 3	18 00		1 - Box & Rod	3 55
			64 09	1 - 1/2" Offset Tail Piece	30
				1 - 1/2" Straight Tail Piece	30
				Littlefield Shovel 2 hrs. @ 7.00	14 00
				Trucking 1 hr. @ .75	75
	Labor				35 72

*Deposited*  
*Expended*  
 Non-Charge

84

Hudley Press, Inc., Lexington

DATE \_\_\_\_\_

# TOWN OF LEXINGTON—BOARD OF PUBLIC WORKS

## WATER DIVISION

The undersigned applies for a supply of water at No. \_\_\_\_\_ St. and hereby agrees to comply with the rules and regulations as now, or at any future time, established by the Board of Selectmen.

Am't. of Estimate \$ \_\_\_\_\_

Owner \_\_\_\_\_


Am't. Paid \$ \_\_\_\_\_

Address \_\_\_\_\_

Builder \_\_\_\_\_

*110 West 1st Street*

Sketch of Service Here

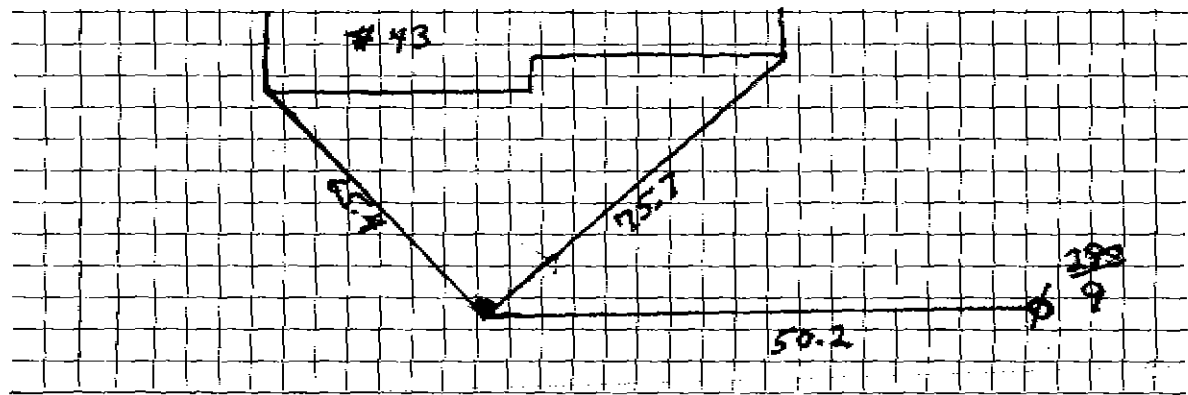

Connection made in \_\_\_\_\_ Street.

Work completed \_\_\_\_\_ 19

Remarks: