

Name F. J. Conti  
 Address 47 Buckman Drive  
 Lexington

Service No. 127

Location 47 Buckman Drive

Kind of Pipe ~~Repair - Renewal~~ - New Service  
 Size Com. 9-5-50  
 Size of Main  
 Location

Date	Material	Amount	Total	Date	Location	Amount
June 28 '50	Labor	4 00		June 10 '50	Repaired	75 00
	10% Overhead	40	4 40			19 67
	43' - 3/4" Copper Tubing @ 23¢		9 89			55 19
	1 - 3/4" C x 1/2" I.W.H. S&W		3 29		No Charge	
	2 hrs. Littlefield Shovel		14 00	June 28 '50	Labor	8 50
	1 hr. Trucking		75		37' - 3/4" Copper Tubing @ 23¢	8 51
	Patching 23 x 3		23 00		1 - 3/4" Corp-cock	3 15
			55 19		2 - 3/4" C x 3/4" C. Curb-cock	3 85
					1 Box & Rod	3 35
					1 - 1/2" Offset Tail Piece	38
					1 - 1/2" Straight Tail Piece	38
					2 hrs. Littlefield Shovel	14 00
					1 hr. Trucking	75
						42 87
4/22/75	22' 3/4" COPPER					
	1 3/4" UNION					

DATE \_\_\_\_\_

# TOWN OF LEXINGTON - BOARD OF PUBLIC WORKS

## WATER DIVISION

The undersigned applies for a supply of water at No. .... St. and hereby agrees to comply with the rules and regulations as now, or at any future time, established by the Board of Selectmen.

Estimate \$.....


Owner .....

Paid \$.....

Address .....

Builder .....

Sketch of Service Here

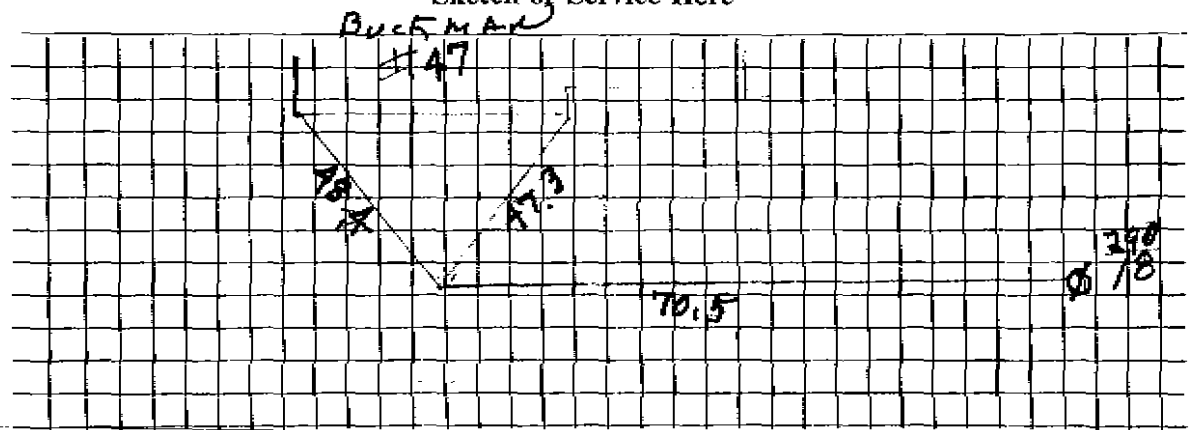

Connection made in ..... Street.

Work completed .....19

Remarks: