

WATER SERVICE RECORD

Name D. Lawrence Anderson

Service No. 361

Address 58 Buckman Drive

Location Lexington, Mass.

~~Repair - Alterations~~ - New Service


Com. 12-31-50

Date	Material	Amount	Total	Date	Material	Amount
Dec. 4, '50	Labor	3 85	3 85	Nov. 29, '50	Hydro-test	60 00
	10% Overhead		39		Exp. fee	5 00
	55' - 3/4" Copper Tubing @ .334	18 37	37		No Charge	54 62
	1 - 3/4" C x 1/2" I.W.H. S&W	3 76	76	Dec. 4, '50	Labor	6 55
	Littlefield Shovel 3 hrs. @ 7.00	21 00	21 00		10' - 3/4" Copper Tubing @ .334	3 34
	Trucking 1 hr. @ .75		75		1 - 3/4" C Yorb-cock	3 60
	Patching 6 x 3		6 00		1 - 3/4" C x 3/4" C Curb-cock	4 40
			54 12		1 - Box & Rod	3 70
					1 - 1/2" Offset Tail Piece	42
					1 - 1/2" Straight Tail Piece	42
					Littlefield Shovel 1 hr. @ 7.00	7 00
					Trucking 1 hr. @ .75	75
						30 18

DATE _____

TOWN OF LEXINGTON — BOARD OF PUBLIC WORKS
WATER DIVISION

Sketch of Service Here

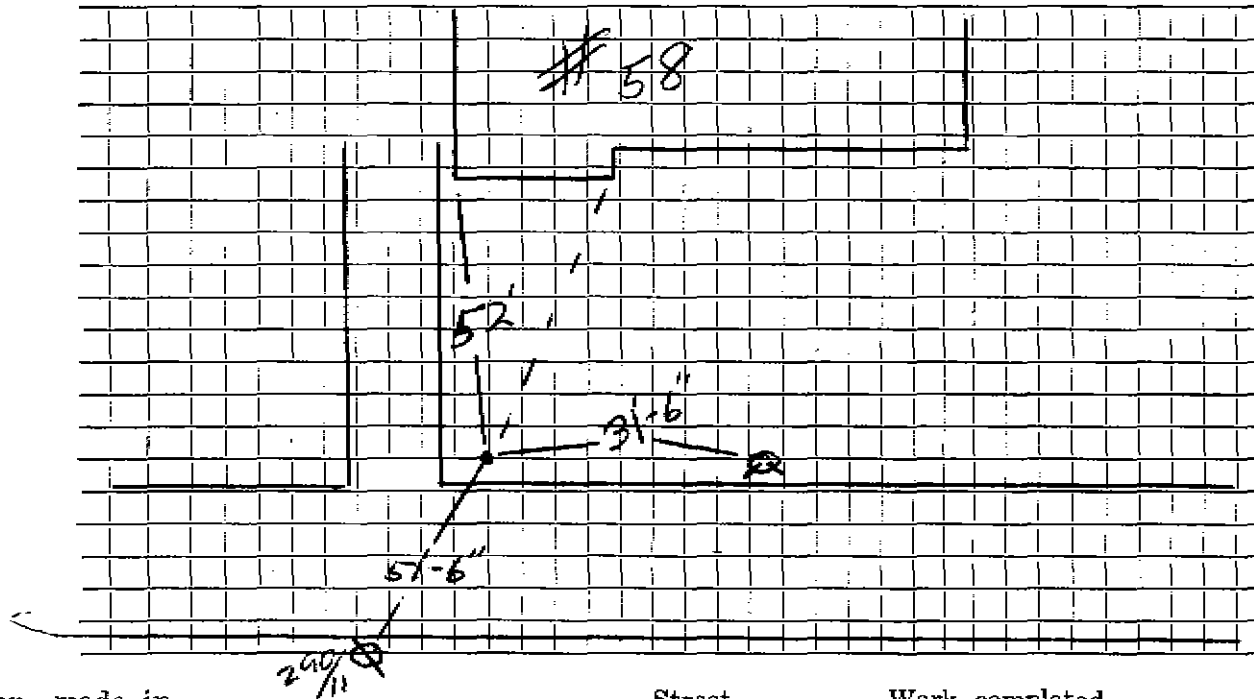

Connection made in _____ Street. Work completed _____

Remarks: Saw it on next curb.