

Name Thomas G. Gallagher

Service No. 166

Address 61 Buckman Drive  
Lexington, Mass.

Location 61 Buckman Drive

Kind of Pipe

Size

Size of Main

~~Repair~~ ~~Renewal~~ New Service

Location

Date	Material	Amount	Total	Date	Location	Amount
Sept. 1, '48	Labor	5 91	5 91	Aug 24 '48	Deposited	75 00
2	Labor	18 20	18 20	25 28 '48	Chg	47 30
3	Labor	23 06	23 06		Non Charge	124 36
4	Labor	6 50	6 50	Sept. 1, '48	Labor	4 09
	10% Overhead		5 37	2	Labor	18 20
	82'-3/4" Copper Tubing		20 91	3	Labor	12 74
	1-3/4" C x 1/2" I.W.H. S & W		3 15	4	Labor	20 77
	1-3/4" C x 3/4" C. Union ( 3 pts.)	1 32	28'-3/4" Copper Tubing			7 14
	3 hrs. Littlefield Shovel	21 00	1-3/4" C. Corp. Cock			3 00
	5 1/2 hrs. Compressor	9 63	1-3/4" C x 3/4" C. Curb Cock			3 68
	10 lbs. Dynamite	2 10	1-Box & Rod			3 55
	11 Explodes	1 21	5 1/2 hrs. Littlefield Shovel			38 50
	<del>2 hrs. Army Truck</del>	6 00	3 1/2 hrs. Compressor			6 13
			124 36	1 hr. D4 Tractor		3 00
	3 1/2 hrs. Army Truck	10 50		11 lbs. Dynamite		2 31
	1-1/2" Offset Tail Piece	30		14 Explodes		1 54
	1-1/2" Straight Tail Piece	30				
	Bill out 10/25/48	135 75				

# TOWN OF LEXINGTON—BOARD OF PUBLIC WORKS

## WATER DIVISION

The undersigned applies for a supply of water at No. \_\_\_\_\_ St. and hereby agrees to comply with the rules and regulations as now, or at any future time, established by the Board of Selectmen.

Am't. of Estimate \$ \_\_\_\_\_


Owner \_\_\_\_\_

Am't. Paid \$ \_\_\_\_\_

Address \_\_\_\_\_

Builder \_\_\_\_\_

Sketch of Service Here

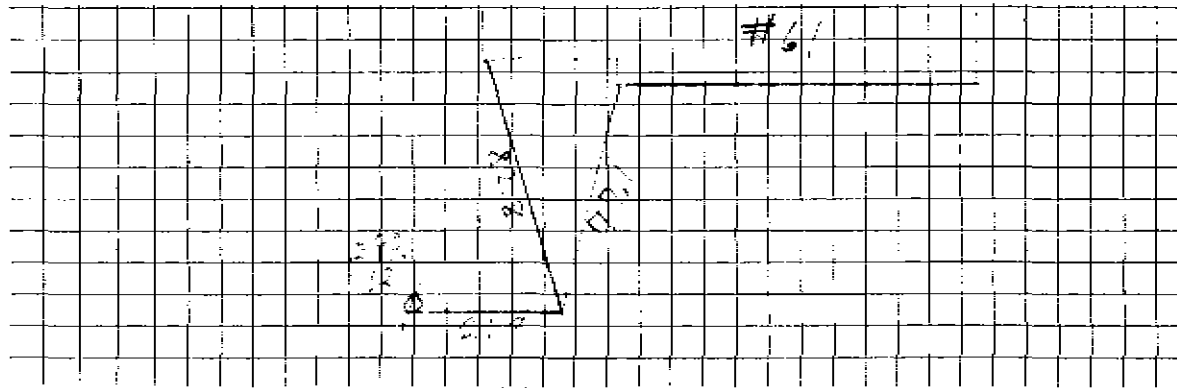

Connection made in \_\_\_\_\_

Street.

Work completed \_\_\_\_\_

Remarks: