

Name A. J. Comeau

Service No. 37

# 4797

Address 69 Buckman Drive

Lexington, Mass.

Location 69 Buckman Drive

Kind of Pipe

Size

Size of Main

~~Repair - Renewal~~ - New Service

Com. 5/22/50

Location

Date	Material	Amount	Total	Date	Amount
Apr. 14, '50	Labor	10 00	10 00	May 20 '50	75 00
	10% Overhead		1 00		1 38
	66' - 3/4" Copper Tubing @.23	15 18	15 18		70 61
	1 - 3/4" C x 1/2" I.W.H. S&W	3 29	3 29	Apr. 14, '50	Labor 40 70
	1 - 3/4" C x 3/4" C Union (3pts)	1 39	1 39		34' - 3/4" Copper Tubing @.23 7 82
	Littlefield Shovel 3 hrs. @7.00	21 00	21 00		1 - 3/4" C Corp-cock 3 15
	Trucking 1 hr. @ 75	75	75		1 - 3/4" C x 3/4" C Curb-cock 3 85
	Patching 18 x 3		18 00		1 - Box & Rod 3 70
			70 61		1 - 1/2" Offset Tail Piece 38
					1 - 1/2" Straight Tail Piece 38
					Compressor 3 hrs. @ 1.75 5 25
					Littlefield Shovel 5 1/2 hrs. @7.00 38 50
	Labor				Trucking 1 hr. @.75 75
					<u>104 48</u>
				Contractor - 7-3-86	2 - 3/4 Comp. Unions
					4' 3/4 Copper

*Manda '50*  
*May 20 '50*  
*Deposited*  
*Refunded*  
No Charge

TOWN OF LEXINGTON - BOARD OF PUBLIC WORKS  
**WATER DIVISION**

The undersigned applies for a supply of water at No. .... St. and hereby agrees to comply with the rules and regulations as now, or at any future time, established by the Board of Selectmen.

Am't of Estimate \$.....


Owner .....

Am't Paid \$.....

Address .....

Builder .....

Sketch of Service Her<sup>2</sup>

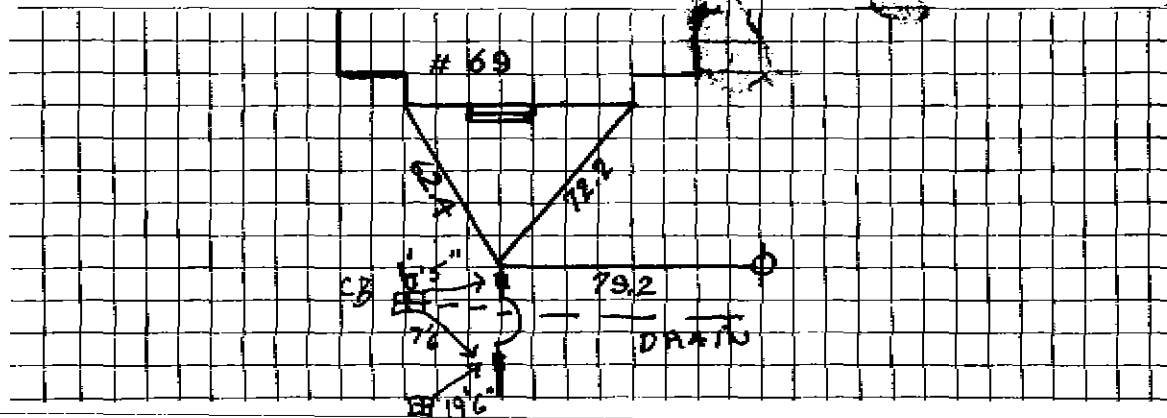

Connection made in Copper under Drain Street.

Work completed .....19

Remarks: