

WATER SERVICE RECORD

1296

Service No.

82

Name Walter Black

Address 7 Buckman Drive

Location Lexington, Mass.

Repair ~~Renewal~~ - New Service


Com. 8-6-51

Date	Material	Amount	Total	Date	Amount
5-18-51	Labor	8 16		May 11, 51	Repaired 70 00
5-23-51	Labor	3 81		10-6-51	218 40 88
5-26-51	Labor	25 30	37 27		No Charge 120 88
	10% Overhead		3 73	5-26-51	Labor 49 11
	60' - 3/4" Copper Tubing @ .326	19 56	20' - 3/4" Copper Tubing @ .326		6 52
	1 - 3/4" x 1/2" I.W.H. S&W	4 00	1 - 3/4" Corp-cock		4 33
	Dynamite 6 lbs. @ .24	1 44	1 - 3/4" x 3/4" Curb-cock		4 67
	Exploders 6 @ .147	88	1 - Box & Rod		4 68
	Compressor 3 hrs. @ 1.75	5 25	1 - 1/2" Offset Tail Piece		50
	Littlefield Shovel 1/4 hrs. @ 7.00	28 00	1 - 1/2" Straight Tail Piece		50
	Trucking 1 hr. @ .75	75	Dynamite 6 lbs. @ .24		1 44
	Patching 20 x 3	20 00	Exploders 6 @ .147		88
		120 88	Compressor 3 hrs. @ 1.75		5 25
			Littlefield Shovel 1/4 hrs. @ 7.00		28 00
			Trucking 1 hr. @ .75		75
					106 63

DATE _____

TOWN OF LEXINGTON — BOARD OF PUBLIC WORKS
WATER DIVISION

Sketch of Service Here

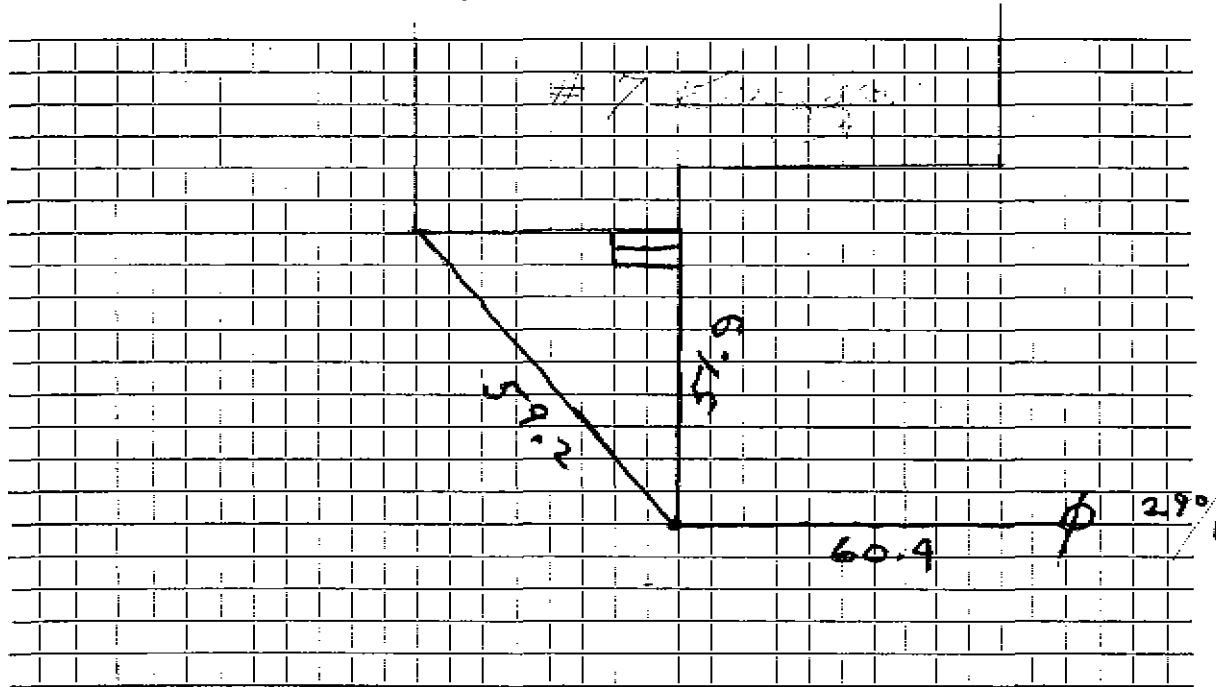

Connection made in Street. Work completed

Remarks:

.....
.....