

WATER SERVICE RECORD

Name Gilbert S. Silvestre

Address 73 Buckman Drive

Location

Repair—Renewal—New Service


Common

Date	Material	Amount	Total	Date	
5/10/56	Labor	3 55		4-18-56	Repair
5/11/56	Labor	20 37		10-18-56	NON CHAR
	10% overhead	2 39	26 31	Labor	
	50' 3/4" copper tubing @ .4850		24 25	7' 3/4" copper tub	
	1 3/4" C x 1/2" I.W.H. stop&waste		4 96	1 3/4" C Corp Cock	
	1 hr. trucking @ .75		75	1 3/4" C Curb Cock	
	10 x 3 patching		10 00	1 Box & Rod	
	4 2/3 hrs. Littlefield @ 8.50		39 66	1 1/2 Straight tail p	
			105 93	1 1/2 Offset tail pie	
				1 hr. Littlefield @	

9-25-56 *Bill sen*

WATER DIVISION

Sketch of Service Here

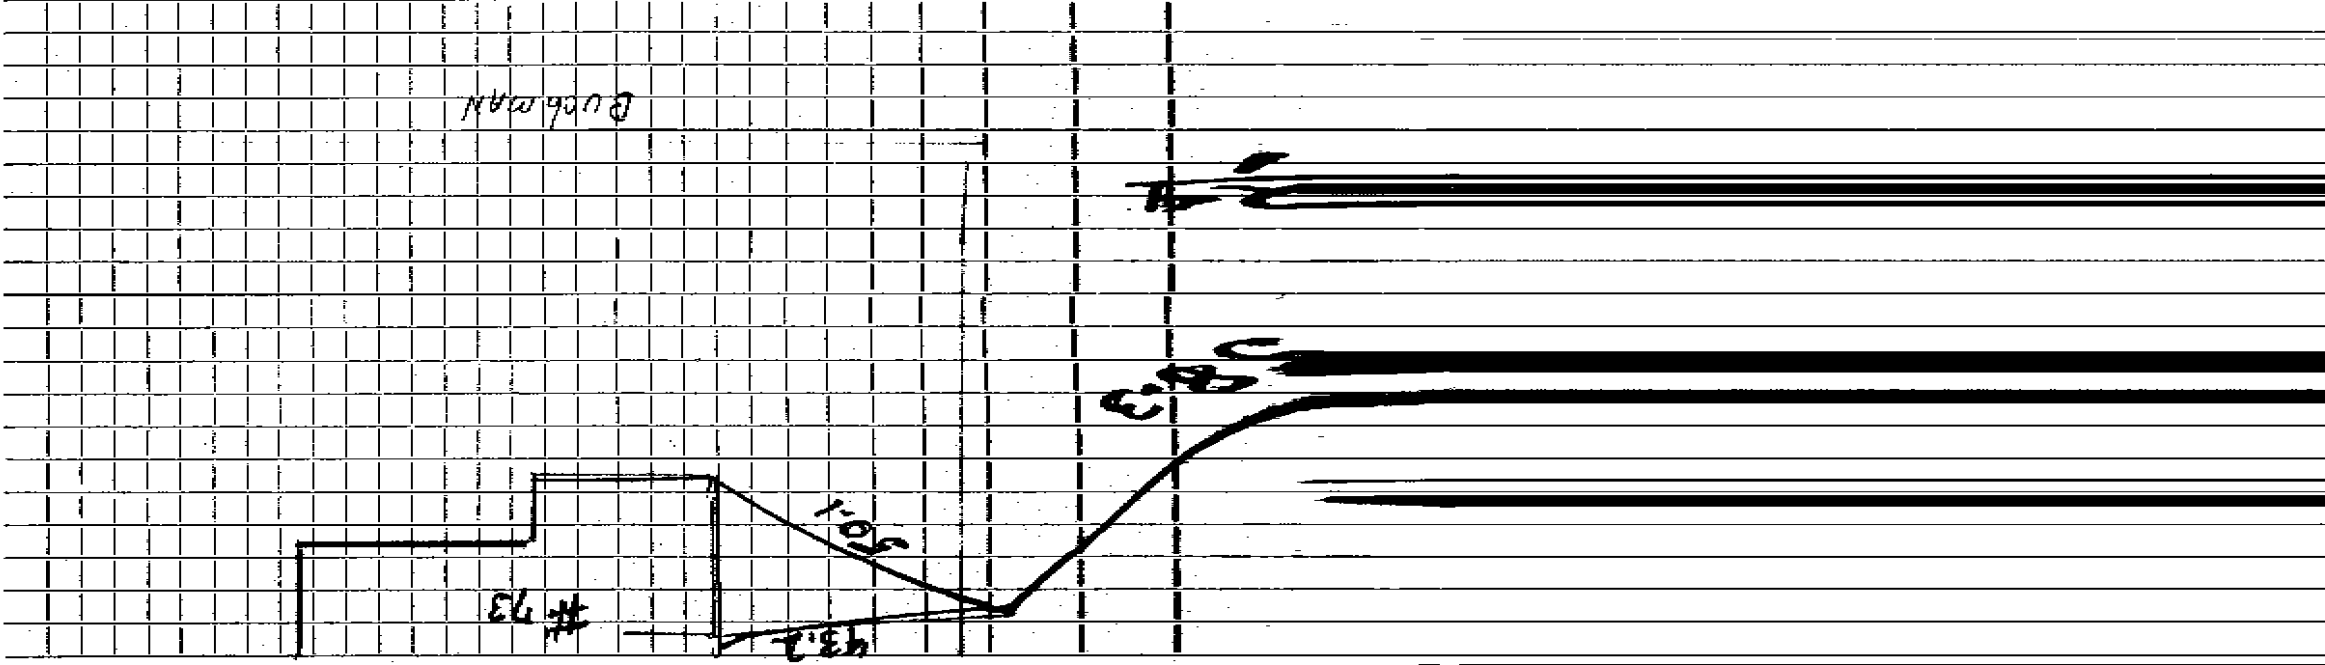


Street. _____

Work completed _____

DATE _____

TOWN OF LEXINGTON — BOARD OF PUBLIC WORKS
WATER DIVISION

Sketch of Service Here

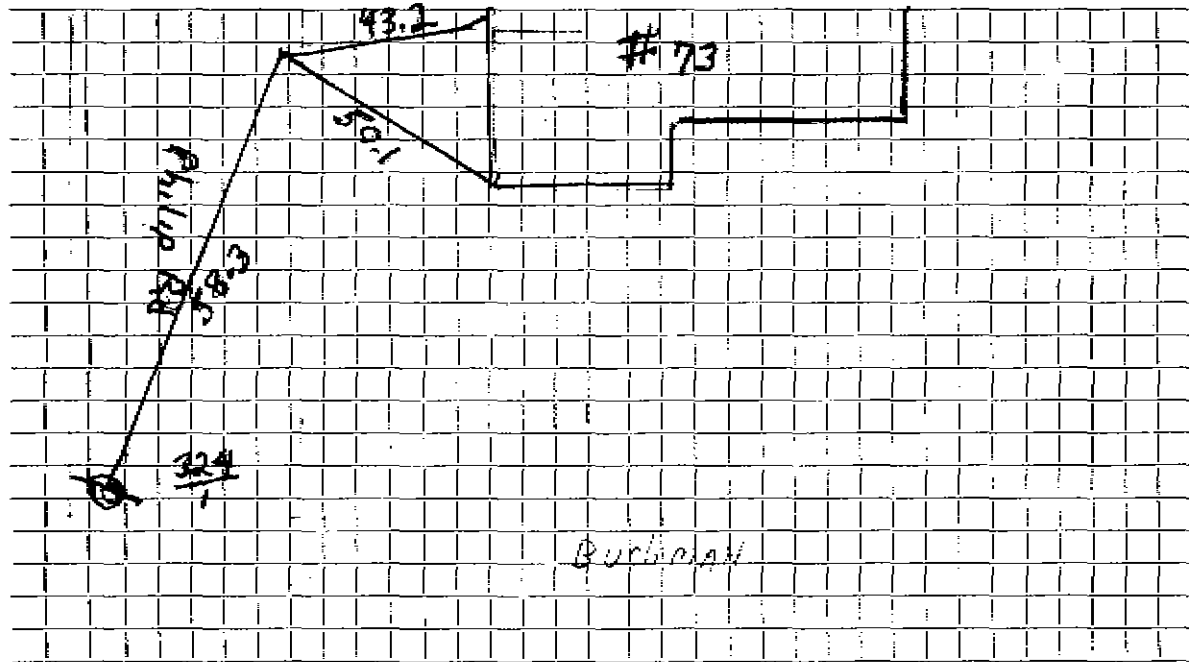

Connection made in Street. Work completed

Remarks:
.....
.....