

Name Lawrence Tierney

Service No. 2

Address 76 Buckman Drive

Lexington, Mass.

Location 76 Buckman Drive

Kind of Pipe

Size

Size of Main

~~Repair~~ ~~Renewal~~ — New Service

Com. 3-8-50

Location

Date	Material	Amount	Total	Date	Amount
Jan. 16 '50	Labor	4 08		Jan. 4 '50	75 00
Jan. 17 '50	Labor	4 55		Jan 9 '50	2
	10% Overhead	86	9 49		54 52
	70'- 3/4" Copper Tubing @ .23		16 10		Non-Charge
	1- 3/4"C x 1/2" I.W.H. S&W		3 29	Jan. 17 '50	Labor 10 00
	1- 3/4"C x 3/4"C Union (3 pts)		1 39		12'- 3/4" Copper @ Tubing .23 2 76
	2 1/2 hrs. Littlefield Shovel		17 50		1- 3/4"C. Corp-cock 3 15
	1 hr. Trucking		75		1- 3/4"C. x 3/4"C. Curb-cock 3 85
	Patching 6 x 3		6 00		1 Box & Rod 3 70
			54 52		1- 1/2" Offset Tail Piece 38
					1- 1/2" Straight Tail Piece 38
					2 hrs. Littlefield 14 00
					1 hr. Trucking 75
	Labor				38 97

DATE _____

TOWN OF LEXINGTON - BOARD OF PUBLIC WORKS

WATER DIVISION

The undersigned applies for a supply of water at No. St. and hereby agrees to comply with the rules and regulations as now, or at any future time, established by the Board of Selectmen.

Am't of Estimate \$.....


Owner

Am't Paid \$.....

Address

Builder

Sketch of Service Here

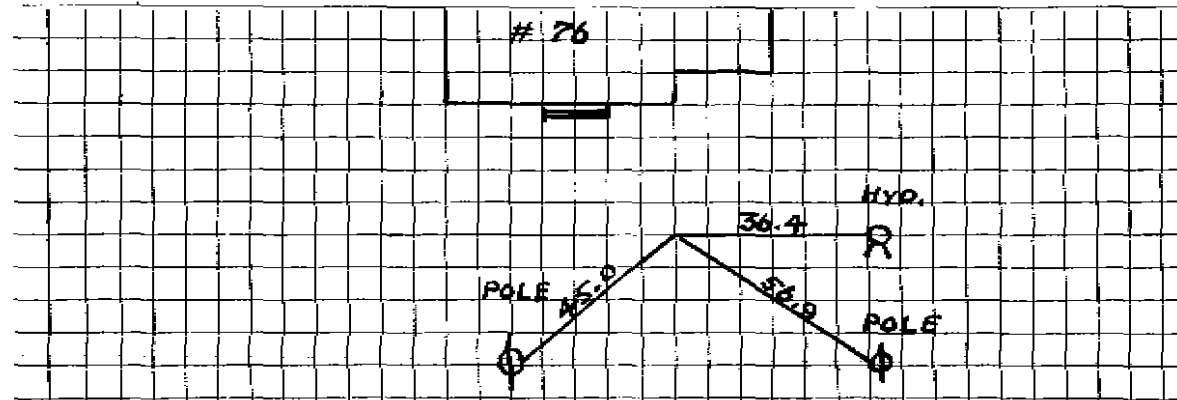

Connection made in Street.

Work completed19

Remarks: