

WATER SERVICE RECORD

Name A. J. Comeau

Service No. 215

Address 79 Buckman Drive

# 3389

Location Lexington

Repair ~~Renewal~~ - New Service COM. 12-8-52


Date	Material	Amount	Total	Date	Amount
10/29/52	Labor	3 19		9-11-52	Deposited 35 00
	10% overhead	32	3 51	12-8-52	* Refunded (8 04)
	55' - 3/4" copper tubing@.34	18 70			NON CHARGE 66 96
	1 -3/4" Cx 1/2 I.W.H. stop & waste	4 00		10/29/52	Labor 3 19
	3 hrs. Littlefield shovel		21 00	20' - 3/4" copper tubing@.34	6 80
	1 hr. trucking		75	1 -3/4" C. corp-cock	4 33
	patching 19 x 3		19 00	1 -3/4" Cx 3/4" C. curb-cock	4 67
			66 96	1 box and red	3 90
				1 -1/2 offset tail pc.	50
				1 -1/2 straight tail pc.	50
				1 hr. Littlefield shovel	7 00
				1 hr. trucking	75
					<u>31 64</u>
				* This refund made payable to M. of Ser. to apply on S.H.C. # 139	

DATE \_\_\_\_\_

TOWN OF LEXINGTON — BOARD OF PUBLIC WORKS

**WATER DIVISION**

Sketch of Service Here

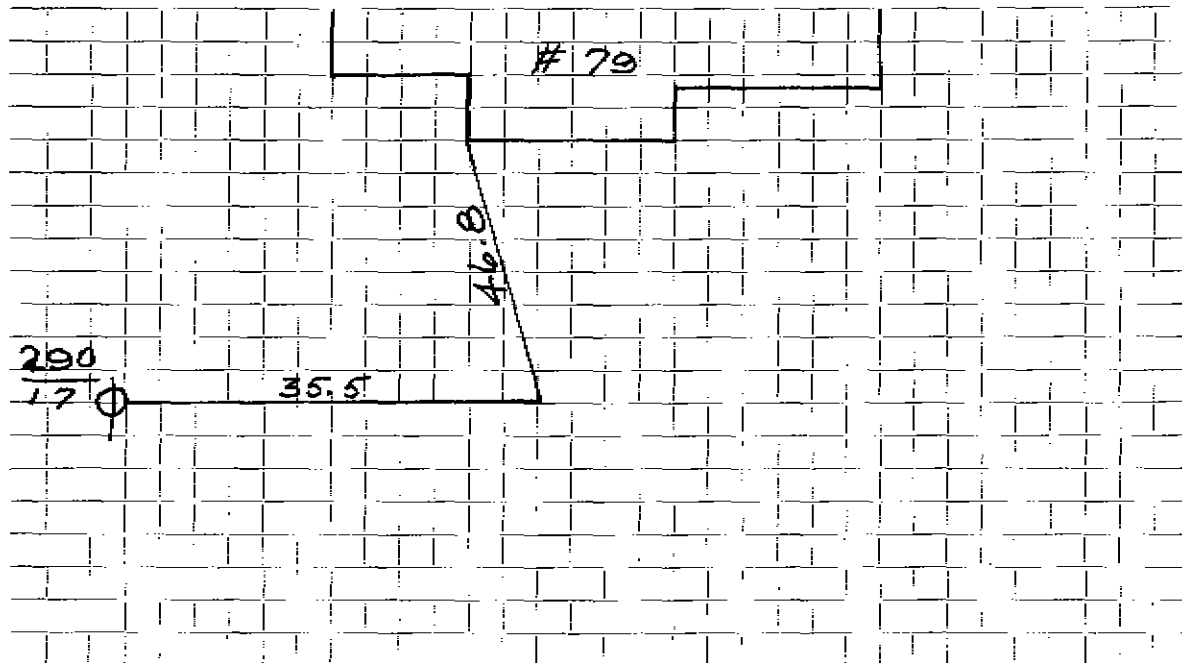

Connection made in ..... Street. Work completed .....

Remarks: .....

.....  
.....