

WATER SERVICE RECORD

Name A. J. Comeau

Service No. 54

Address 80 Buckmar Drive

Location Lexington

Repair ~~Renewal~~ New Service

Com 6-16-52


Date	Material	Amount	Total	Date	Amount
4/22/52	Labor	12 00		4-15-52 Deposited	75 -
	10% overhead	1 20	13 20	6-16-52 Refunded	(4) 13
	82' - 3/4" copper tubing@.3439	28 20			20 87
	1 - 3/4" Cx 1/2" I.W.H. Stop & waste	4 00		NON CHARGE	
	1 - 3/4" Cx 3/4" C. union	1 72		4/22/52 Labor	14 00
	3 hrs. town shovel @ 5.00		15 00	14' - 3/4" copper tubing@.3439	4 81
	1 hr. trucking		75	1 - 3/4" C. corp-cock	4 33
	patching 3 x 3		8 00	1 - 3/4" C. curb-cock	4 67
			70 87	1 box and rod	4 52
				1 - 1/2" offset tail pc.	50
				1 - 1/2" straight tail pc.	50
				1 hr. town shovel	5 00
				1 hr. trucking	75
					39 08

DATE _____

TOWN OF LEXINGTON — BOARD OF PUBLIC WORKS

WATER DIVISION

Sketch of Service Here

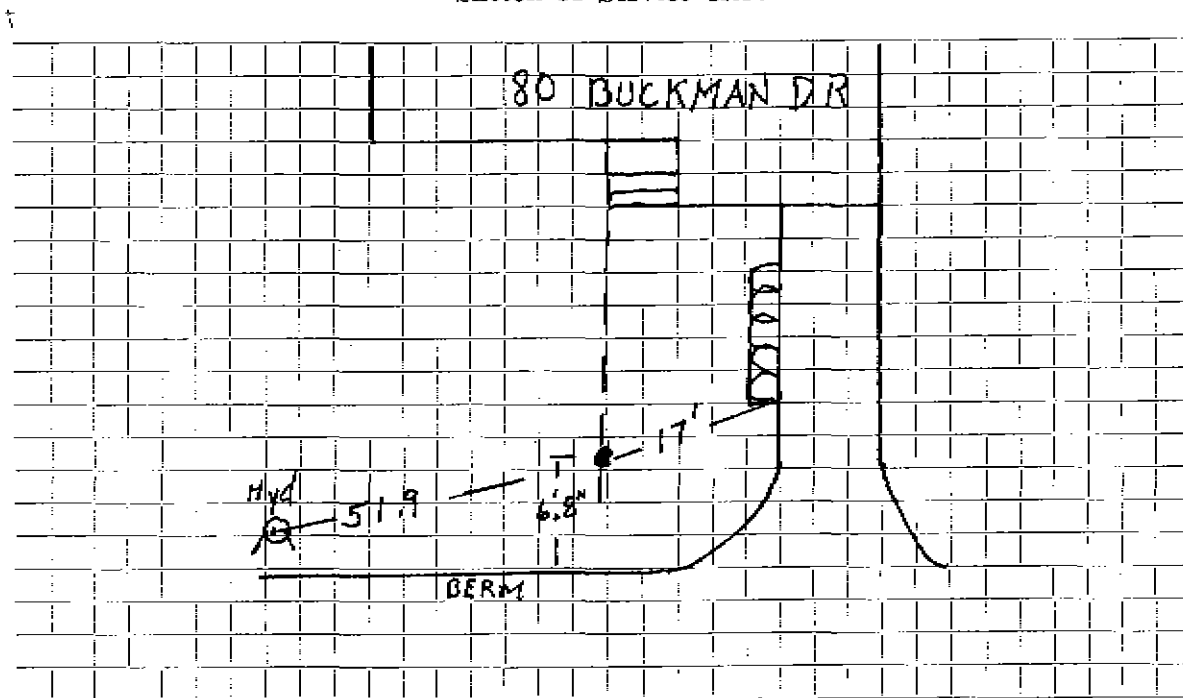

Connection made in Street. Work completed

Remarks:

.....

.....