

WATER SERVICE RECORD

Name Eugene Luongo

Service No. 7

Address 82 Buckman Drive

Location

AUG 6 1979


Repair—Renewal—New Service W.O. #0387 DeFlice #3225

Date	Material	Amount	Total	Date	Amount
6/26/79	Labor	68.72		5-1-79	Deposit 230.00
	10% O.H.	6.87	75.59	8-6-79	Refund 61.28
12'	1" Copper @ .90		10.80		168.72
1	1" Corp		19.65		
1	1" Curb		24.18		
1	Box & Rod		13.50		
4	Hrs. Trucking @ 3.00		12.00		
2	Hrs. Backhoe @ 6.50		13.00		
			\$ 168.72		
7/23/79	37½' 1" Copper tubing inside				
	12' 1" Copper tubing outside				

DATE _____

TOWN OF LEXINGTON — BOARD OF PUBLIC WORKS
WATER DIVISION

Sketch of Service Here

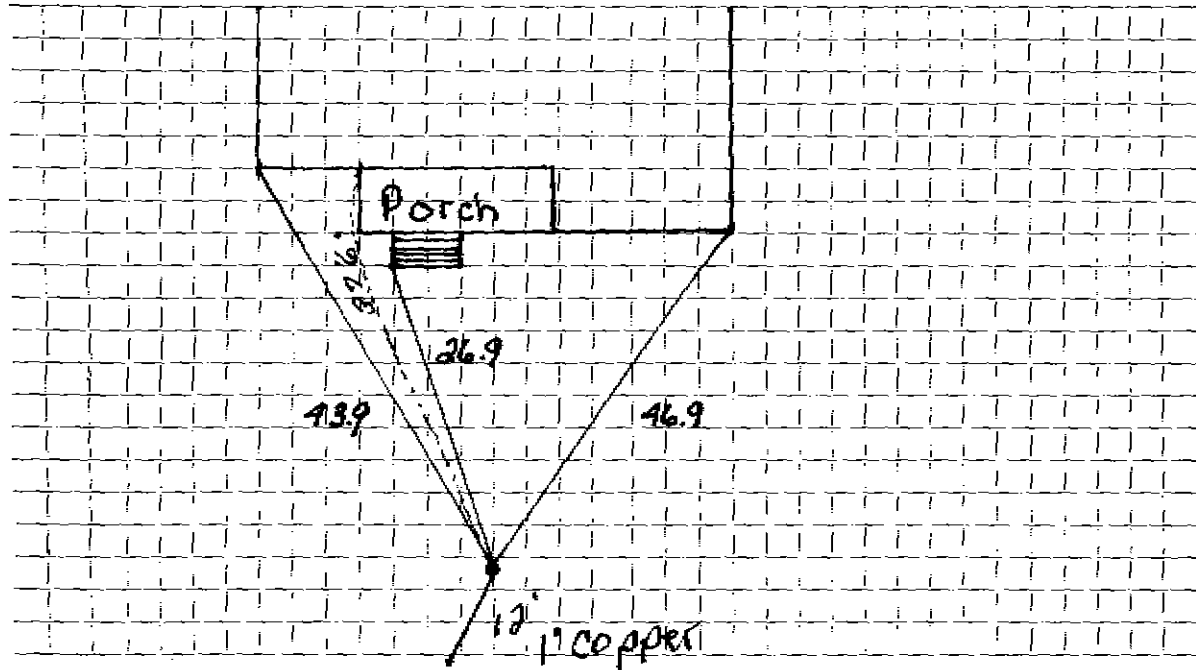

Connection made in Street. Work completed

Remarks:

.....

.....