

#215

WATER SERVICE RECORD

Name Leeland Construction Co.

Service No. 29

Address 112 Burlington Street

Location

RIDGEWOOD - New Service

Date 3-22-54


Date	Material	Amount	Total	Date		Amount
3/5/54	Labor	9.50		3-19-54	Deposited	25.00
	10% overhead	.95	10.45	3-22-54	Prefunded	13.78
	40' -3/4" copper tubing@.3629	14.52			NON CHARGE	62.22
	1 -3/4" C x $\frac{1}{2}$ I.W.H. stop & waste	4.00	3/5/54 Labor			9.50
	3 hrs. Littlefield shovel@7.50	22.50	10' - 3/4" copper tubing@.3629			31.63
	1 hr. trucking	1.75	1 -3/4" C. corp-cock			4.33
	patching 10 x 3	10.00	1 -3/4" C x 3/4" C. curb-cock			4.67
		62.22	1 box and rod			3.90
			1 - $\frac{1}{2}$ offset tail pc.			.50
			1 - $\frac{1}{2}$ straight tail pc.			.50
			1 hr. Littlefield shovel			7.50
			1 hr. trucking			.75
						35.28

DATE _____

TOWN OF LEXINGTON — BOARD OF PUBLIC WORKS

WATER DIVISION

Sketch of Service Here

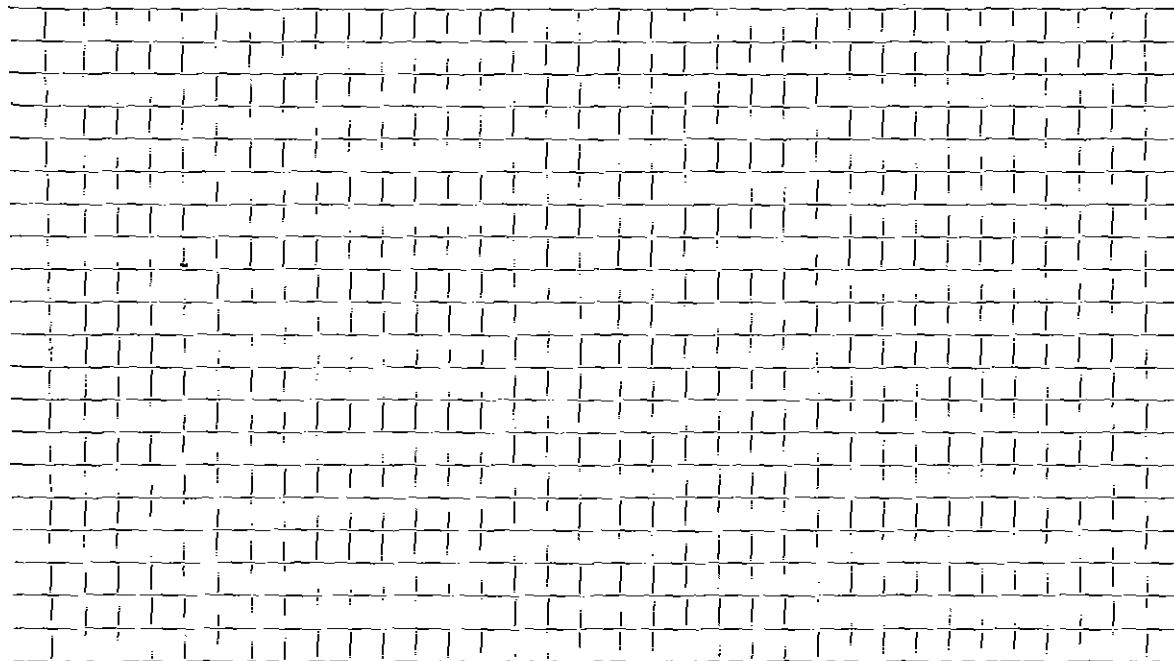

Connection made in Street. Work completed

Remarks:

.....
.....