

WATER SERVICE RECORD

Name Nishon Gardner

Service No. 40

Address 101 Burlington Street

# 5877

Location Lexington, Mass.

~~Repair~~ ~~Renewal~~ New Service


Com. 5-21-51

Date	Material	Amount	Total	Date	Material	Amount
4-5-51	Labor	5 35	5 35	7/25/51	Reported	100 00
	10% Overhead		54			
	129' - 3/4" Copper Tubing @ .36	46 44	46 44		No Charge	96 52
	1 - 3/4" C x 1/2" I.W.H. S&W	4 00	4 00	4-5-51	Labor	9 00
	2 - 3/4" C x 3/4" C Unions (3pts)	3 44	3 44		12' - 3/4" Copper Tubing @ .36	4 32
	Littlefield Shovel 4 hrs. @ 7.00	28 00	28 00		1 - 3/4" C Corp-cock	4 33
	Trucking 1 hr. @ .75		75		1 - 3/4" C x 3/4" C Curb-cock	4 67
	Patching 8 x 3		8 00		1 - Box & Rod	4 68
			96 52		1 - 1/2" Offset Tail Piece	50
					1 - 1/2" Straight Tail Piece	50
					Littlefield Shovel 1 hr. @ 7.00	7 00
					Trucking 1 hr. @ .75	75
						35 75

DATE \_\_\_\_\_

TOWN OF LEXINGTON — BOARD OF PUBLIC WORKS  
WATER DIVISION

Sketch of Service Here

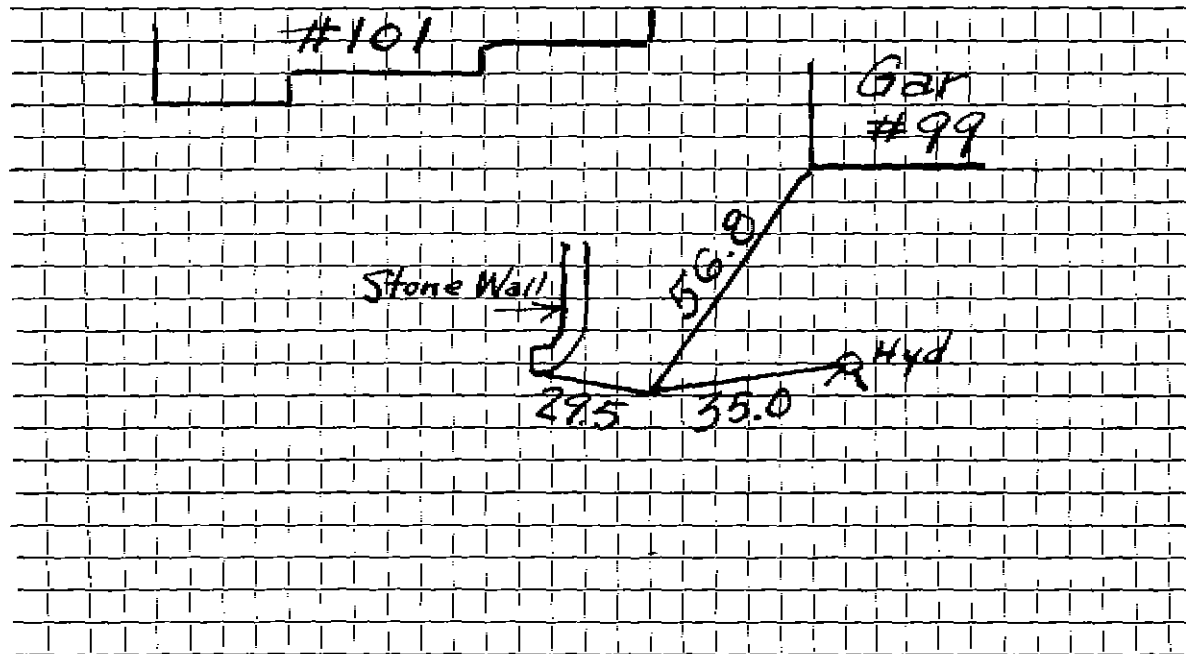

Connection made in ..... Street. Work completed .....

Remarks: .....

.....

.....