

WATER SERVICE RECORD

Name Douglas Wacome

Service No. 169

Address 102 Burlington St.

Location

~~Repair/Reconnect~~ - New Service

Com. 8-10-53


Date	Material	Amount	Total	Date	Amount
7/14/53	Labor	6 62		6-25-53 Deposited	75 00
	10% overhead	66	7 28	8-10-53 Refunded	11 91
	47' - 3/4" copper tubing@.3629		17 06		63 09
	1 - 3/4"C x 1/2 I.W.H. stop& waste		4 00	7/15/53 Labor	13 24
	2 hrs. Littlefield shovel@ 7.50		15 00	22' - 3/4" copper tubing@.3629	7 98
	1 hr. trucking		75	1 -3/4"C. corp-cock	4 33
	patching 19 x 3		19 00	1 -3/4"C x 3/4"C. curb-cock	4 67
			63 09	1 box and rod	3 90
				1 -1/2 offset tail piece	50
				1 -1/2 straight tail piece	50
				2 hrs. Littlefield shovel @ 7.50	15 00
				1 hr. trucking	75
					50 87

DATE _____

TOWN OF LEXINGTON - BOARD OF PUBLIC WORKS

WATER DIVISION

Sketch of Service Here

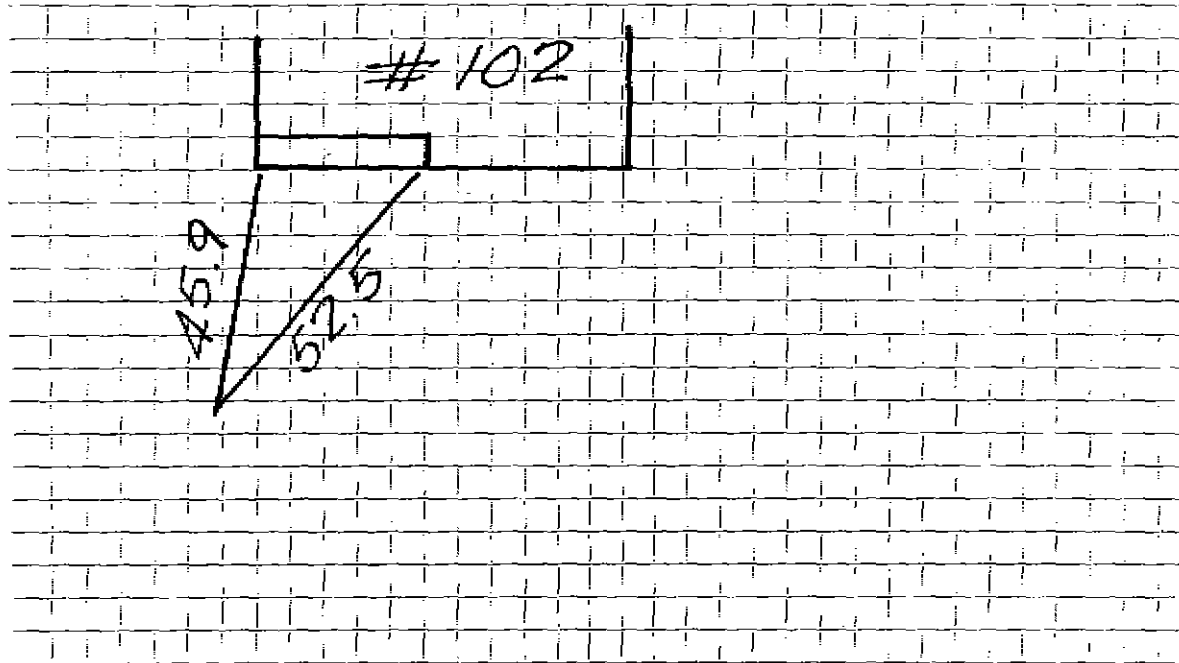

Connection made in Street. Work completed

Remarks:

.....
.....