

WATER SERVICE RECORD

Name Kenneth Kiley

Service No. # 1673
2420
14

Address 105 Burlington Street

7397

Location

Repair ~~XXXXXX~~ New Service


Comm 6-16-61

Date	Material	Amount	Total	Date	Material	Amount
4-25-61	Labor	23.54		3-29-61	Deposit	150.00
	10% O.H.	2.35	25.89	6-19-61	Retard	64.81
89'	3/4" Copper Tubing @.42		37.38		NON CHARGE	85.19
1	3/4" c x 1/2 I.W.H. Stop & Waste	6.17		4-25-61	Labor	1.33
1	1/2 Hr. Town Shovel @6.50		9.75	5'	3/4" Copper Tubing @.42	2.10
1	Hr. Trucking @3.00		3.00	1	3/4" C Corp Cock	4.91
	3 x 3 Patch		3.00	1	3/4" C Curb Cock	6.28
			85.19	1	Box & Rod	4.90
				1	1/2 Straight tailpiece	.50
				1	1/2 Offset tailpiece	.50
				1/2	Hr. Town Shovel @6.50	3.25
						23.77
				7/26/78	12' 3/4 COPPER	
					1 3/4 3 PART UNION	
					1 Box + Rod	

DATE _____

TOWN OF LEXINGTON — BOARD OF PUBLIC WORKS
WATER DIVISION

Sketch of Service Here

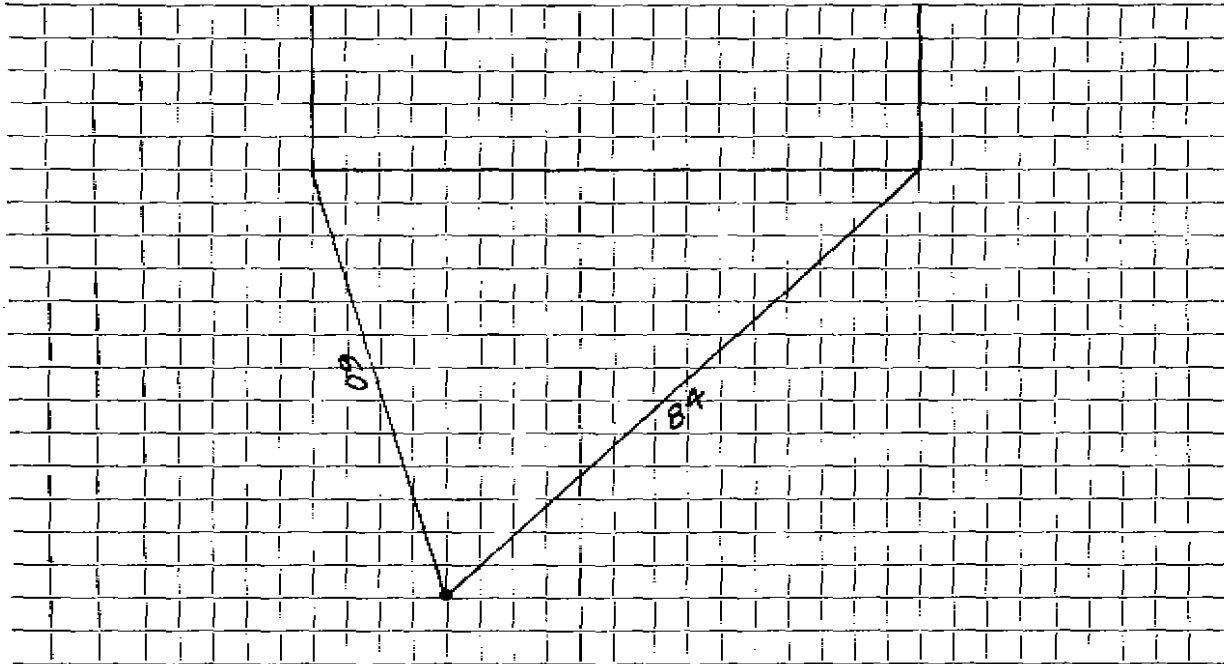

Connection made in Street. Work completed

Remarks:

.....

.....