

WATER SERVICE RECORD

Name Ralph Harris

Service No. _____

Address 109 Burlington Street

Location _____


~~Renewal~~ New Service Com. 12/31/51

Date	Material	Amount	Total	Date	Material	Amount
11/23/51	Labor	5.41		11/23/51	Deposit	100.00
	10% O.H.	.54	5.95	12/31/51	Refund	30.87
	85' 3/4" Copper tubing @.326		27.71			69.13
1	3/4" C x 1/2 I.W.H. S & W		4.00		OUTSIDE	
1	3/4" C x 3/4" C Union 3 part		1.72	11/23/51	Labor	5.41
3	hrs. Littlefield Shovel @ \$7.00		21.00	18'	3/4" Copper Tubing @.326	5.86
1	hr. Trucking		.75	1	3/4" C Corp Cock	4.33
	Patching 8 x 3		8.00	1	3/4" Curb Cock	4.67
			\$69.13	1	Box & Rod	4.68
				1	1/2 Offset Tail Piece	.50
				1	1/2 Straight Tail Piece	.50
				1	hr. Littlefield Shovel	7.00
				1	hr. Trucking	.75
						\$33.70

DATE _____

TOWN OF LEXINGTON — BOARD OF PUBLIC WORKS
WATER DIVISION

Sketch of Service Here

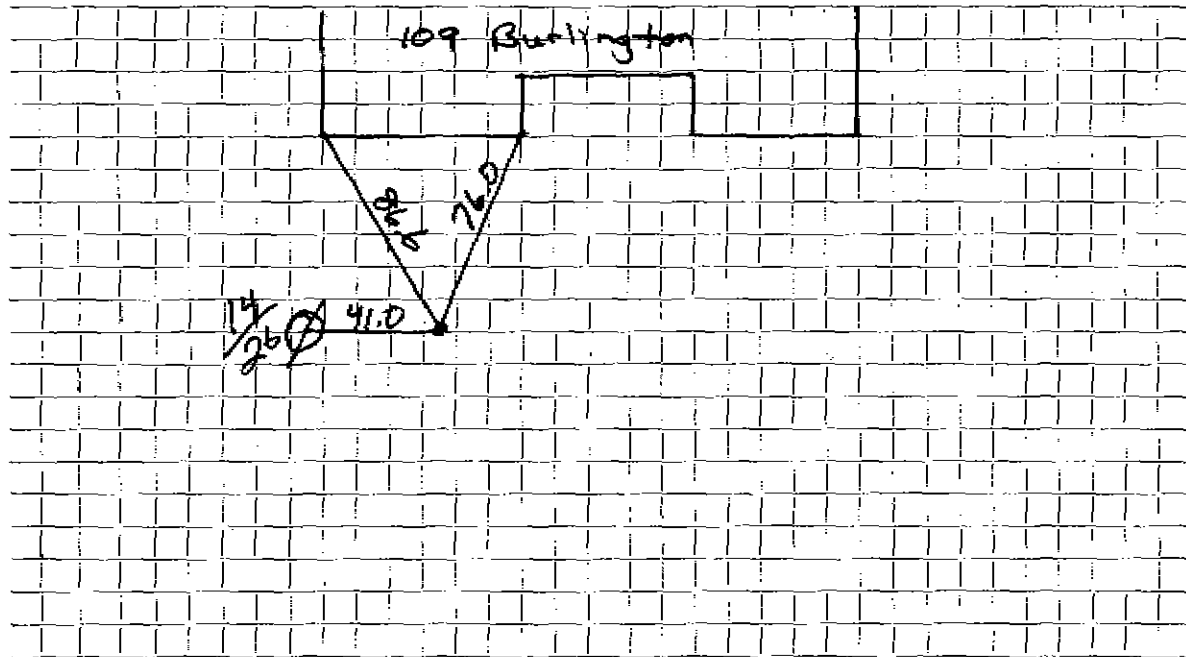

Connection made in Street. Work completed

Remarks: 2' deep @ Curb Box