

WATER SERVICE RECORD

Name Louis Stoico
 Address 111 Burlington St., Lexington, Mass.

Service No. 250

Location

Required ~~Renewal~~ New Service

~~7357~~# 7414Comm. 12/31/57


Date	Material	Amount	Total	Date	Amount
11/15/57	Labor	23 99		10-28-57	Deposit \$100 00
	10% Overhead	2 40	26 39	12-31-57	Refund 16 64
	77'-3/4" Copper tubing @.37		28 49		\$83 36
	1-3/4" C x 1/2" IWH stop & waste		4 96		
	1-3/4" C union 3 part		2 27		Non Charge
	10 x 3 patch		10 00		14'-3/4" Copper tubing @.37-
	2 hrs. trucking @.75		1 50		Labor 4 37
	1 1/2 hr. Town shovel @ 6.50		9 75		1-3/4" C Corp Cock 4 64
			83 36		1-3/4" C Curb cock 5 94
					1 Box & Rod 4 62
					1-1/2 straight tailpiece 50
					1-1/2 offset tailpiece 50
					1 hr. trucking @.75 75
					1/2 hr. Town shovel @ 6.50- 3 25
					29 75

DATE _____

TOWN OF LEXINGTON — BOARD OF PUBLIC WORKS

WATER DIVISION

Sketch of Service Here

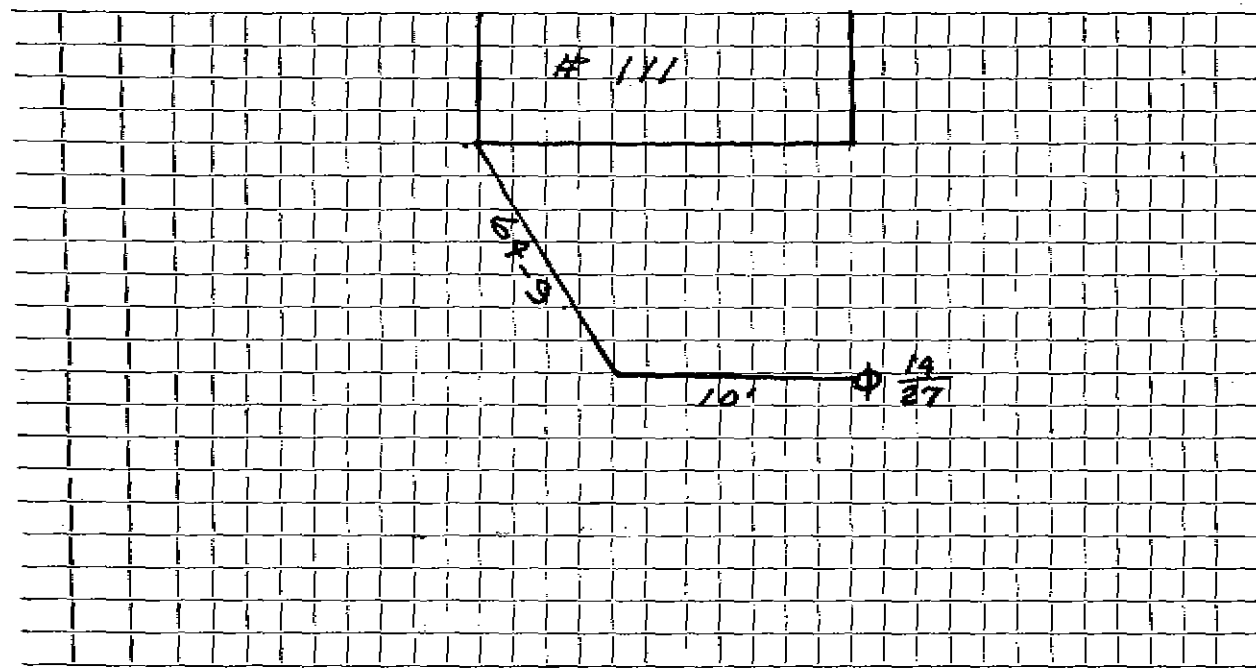

Connection made in Street. Work completed

Remarks:
.....
.....