

WATER SERVICE RECORD

Name R. H. Hersom

Service No. ³⁷³⁷
153

Address 1114 Burlington St.

Location Lexington

Repair ~~Renovate~~ New Service

Per 9-29-52


Date	Material	Amount	Total	Date	Amount
9/3/52	Labor	3 19		222-52 9-29-52	30.00
	10% Overhead	32	3 51	<i>Deposited</i> <i>Refunded</i>	6.76
	47' - 3/4" Copper tubing@.34	15 98		NON CHARGE	3.19
	1 - 3/4" C x 1/2 I.W.H. stop&waste	4 00		9/3/52	3 19
	1 hr. Littlefield shovel	7 00		15' - 3/4" Copper tubing@.34	5 10
	1 hr. trucking	75		1 - 3/4" C. corp-cock	4 33
	patching 12 x 3	12 00		1 - 3/4" C x 3/4" C. curb-cock	4 67
		43 24		1 box and rod	3 90
				1 - 1/2 offset tail piece	50
				1 - 1/2 straight tail piece	50
				1 hr. Littlefield shovel	7 00
				1 hr. trucking	75
					29 94

DATE _____

TOWN OF LEXINGTON — BOARD OF PUBLIC WORKS

WATER DIVISION

Sketch of Service Here

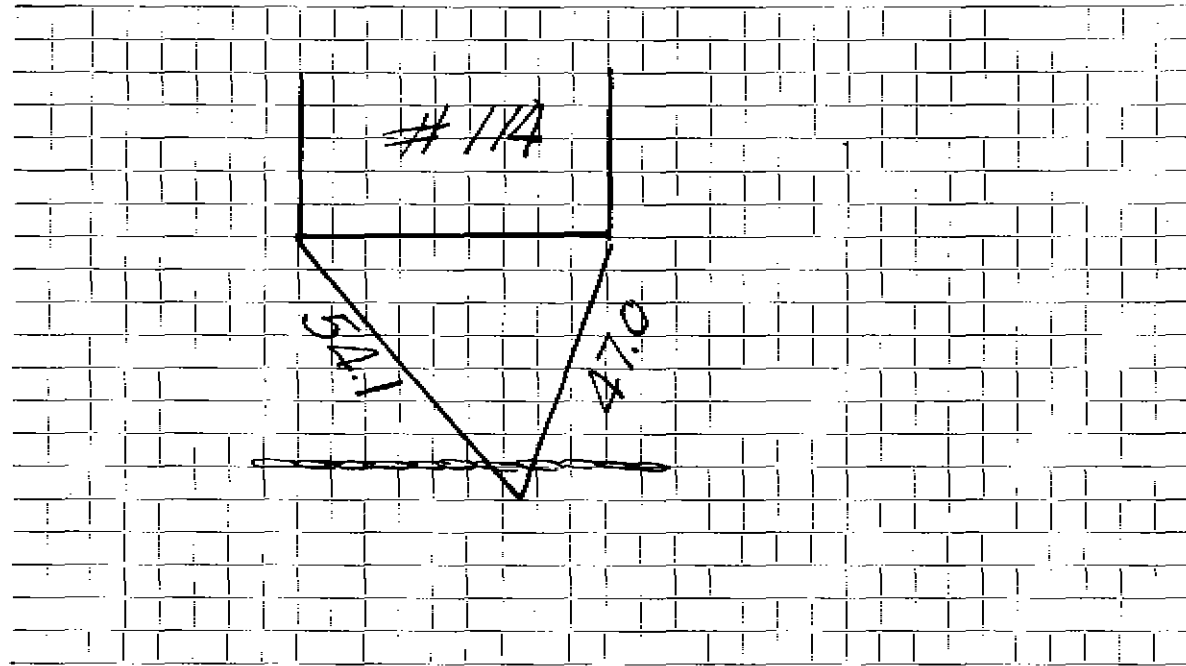

Connection made in Street. Work completed

Remarks:

.....

.....