

WATER SERVICE RECORD

# 5531

Name Eliot Eames

Service No. 190

# 6186

Address 115 Burlington Street

Location Lexington, Mass.


~~Repair - Renewal~~ - New Service *Com. 10/1/51*

Date	Material	Amount	Total	Date		Amount
8-17-51	Labor	6 79	6 79	8-15-51	Deposited	90 00
	10% Overhead		68	10-1-51	Refunded	62 21
	68'-3/4" Copper Tubing @.326	22 16	22 16			37 00
	1-3/4" Cx 1/2" I.W.H. S&W	4 00	4 00		No Charge	
	1-3/4" Cx 3/4" C Union (3 pts)	1 72	1 72	8-17-51	Labor	8 70
	3 Hr. Littlefield Shovel	21 00	21 00	7'-3/4" Copper Tubing @.326		2 28
	1 Hr. Trucking	75	75	1-3/4" C Corp-Cock		4 33
			57 19	1-3/4" Cx 3/4" C Curb-Cock		4 67
				1 Box & Rod		4 68
				1-1/2" Offset Tail Piece		50
				1-1/2" Straight Tail Piece		50
				1 Hr. Littlefield		7 00
				1 Hr. Trucking		75
						33 41

DATE \_\_\_\_\_

TOWN OF LEXINGTON — BOARD OF PUBLIC WORKS  
WATER DIVISION

Sketch of Service Here

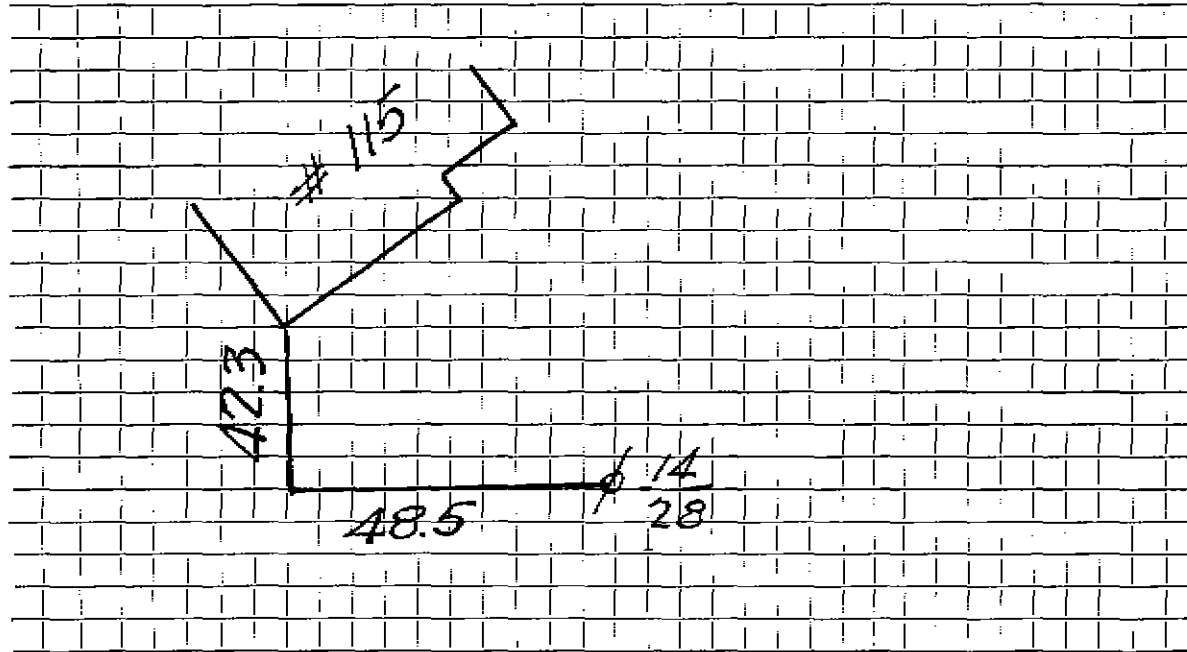

Connection made in ..... Street. Work completed .....

Remarks: .....

.....

.....