


DATE 6/5/18

TOWN OF LEXINGTON — BOARD OF PUBLIC WORKS

WATER DIVISION

Sketch of Service Here

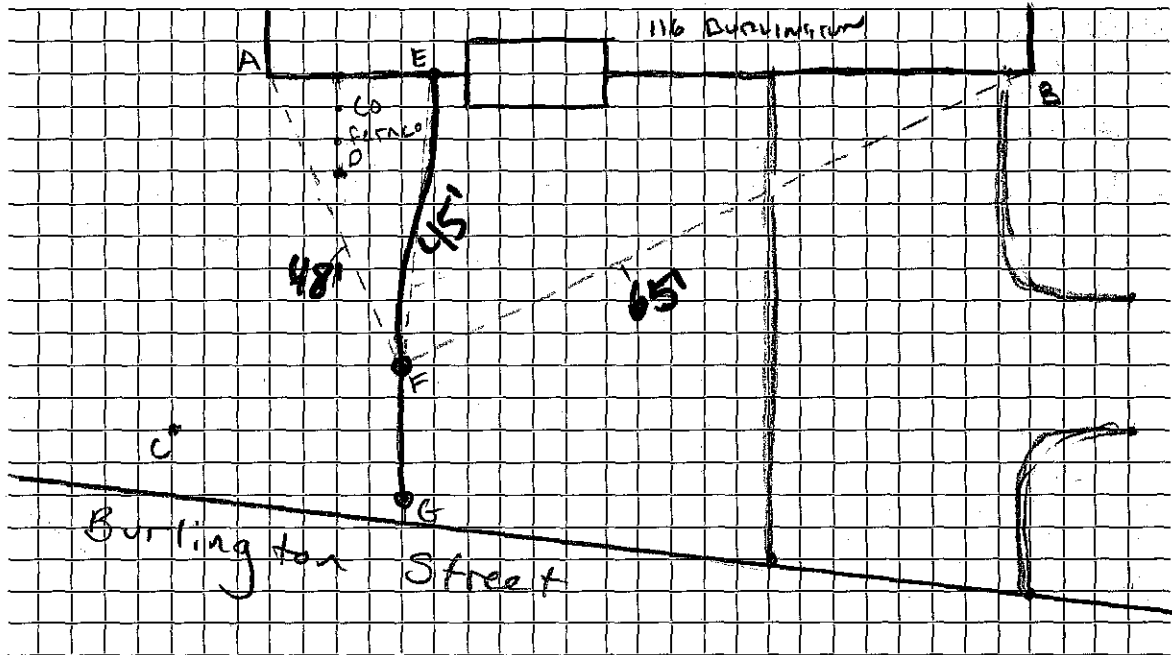

AF = 48'
 BF = 65'
 EF = 45'

Connection made in... Burlington Street. Work completed

Remarks: (br. gullage took these ties)
 G = curbstop F = 1" Union