

Name John McAvoy
 Address 117 Burlington Street
 Lexington, Mass.

Service No.

3287

2122

Location 117 Burlington Street

Kind of Pipe

Size

Size of Main

~~Repair~~—~~Renewal~~—New Service

Location

Date	Material	Amount	Total	Date	Amount
June 23, '47	Labor	4 55		June 19, '47	50 00
27	"	14 79	19 34	Sept 25, '47	28 93
	10% Overhead		1 93		21 27
			21 27		
	(Pipe supplied by owner)				
	Labor			"	Copper outside

TOWN OF LEXINGTON – BOARD OF PUBLIC WORKS
WATER DIVISION

The undersigned applies for a supply of water at No..... St. and hereby agrees to comply with the rules and regulations as now, or at any future time, established by the Board of Selectmen.

Am't of Estimate \$.....


Owner

Am't Paid \$.....

Address

Builder

Sketch of Service Here

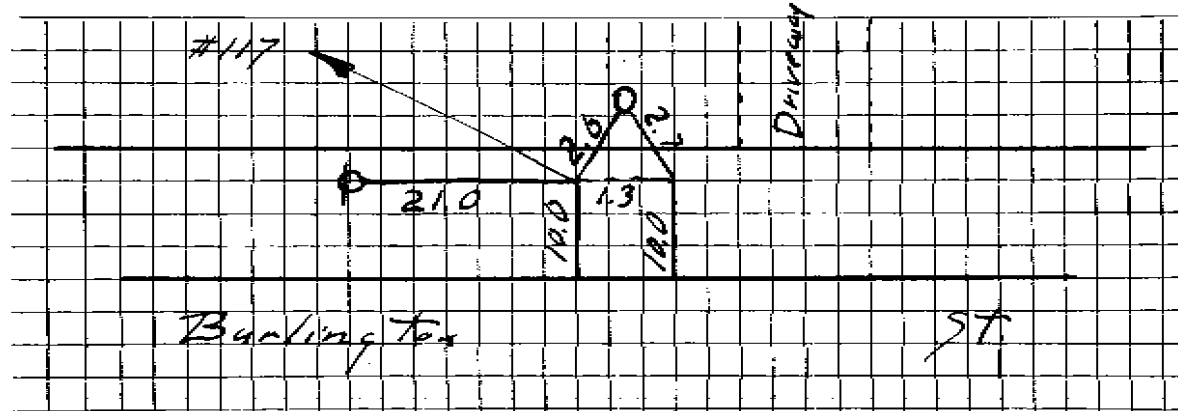

Connection made in Street.

Work completed19

Remarks: