

Name **Glenny S. Cutter**
 Address **118 Burlington Street**
Lexington, Mass.

Service No.

#166

Location **118 Burlington Street**

Kind of Pipe

Size

Size of Main

~~Repair~~ ~~Renewal~~ — New Service Com. June 7, 1948

Location

| Date | Material | Amount | Total | Date | Amount |
|--------------|--------------------------------|--------|-------|---------------------------------|--------|
| Apr. 27, '48 | Labor | 1 05 | 1 05 | April 24 '48 | 20 00 |
| | 10% Overhead | | 11 | Sept 2 '48 | 362 |
| | 48' - 3/4" Copper Tubing @.255 | 12.24 | | | 28 62 |
| | 1 - 3/4" C x 1/2" I.W.H. S & W | 3 15 | | | |
| | 1 - 3/4" C x 3/4" C Union 3pts | 1 32 | | Apr. 27, '48 | 10 30 |
| | Trucking 1 hr. @.75 | 75 | | 20' - 3/4" Copper Tubing @.255 | 5 10 |
| | Patching 10 x 3 | 10 00 | | 1 - 3/4" C Corp-cock | 3 00 |
| | | | 28 62 | 1 - 3/4" C x 3/4" C Curb-cock | 3 68 |
| | | | | 1 - Box & Rod | 3 50 |
| | | | | Littlefield Shovel 2 hrs. @7.00 | 14 00 |
| | | | | 1 - 1/2" Offset Tail Piece | 30 |
| | | | | 1 - 1/2" Straight Tail Piece | 30 |
| | | | | Trucking 1 hr. @.75 | 75 |
| | | | | | 40 93 |
| | Trench dug by owner | | | | |
| | Labor | | | | |

Deposited
Paid
 Non-Charge

Hadley Press, Inc., Lexington

DATE _____

TOWN OF LEXINGTON—BOARD OF PUBLIC WORKS

WATER DIVISION

The undersigned applies for a supply of water at No. _____ St. and hereby agrees to comply with the rules and regulations as now, or at any future time, established by the Board of Selectmen.

Am't. of Estimate \$ _____


Owner _____

Am't. Paid \$ _____

Address _____

Builder _____

Sketch of Service Here

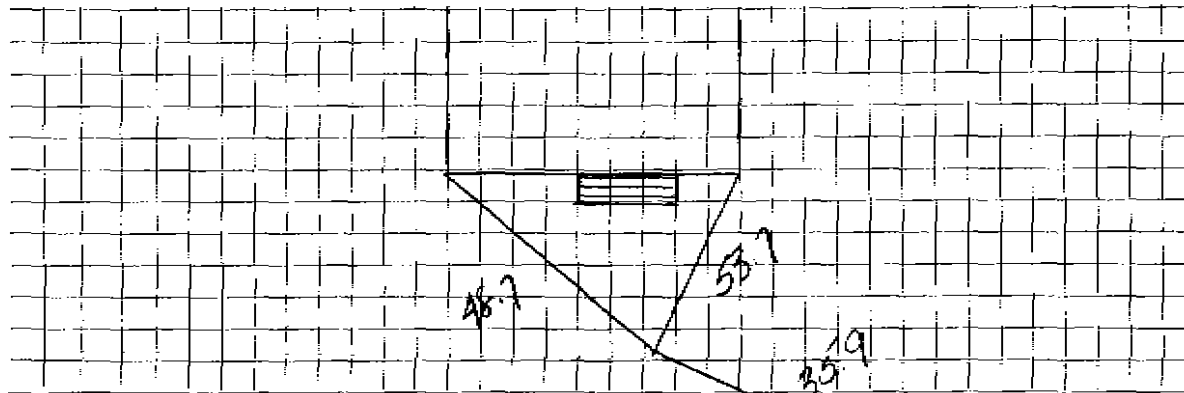

Connection made in _____ Street. Work completed _____ 19

Remarks:

Ø