

Name John J. Mullen

1848  
Service No. 3288  
A 915

Address 119 Burlington Street  
Lexington, Mass.

Location 119 Burlington Street

Kind of Pipe

Size

Size of Main

~~REPAIR - RENEWAL~~ - New Service

Location

Date	Material	Amount	Total	Date	Amount
June 23, '47	Labor	4 55		June 19 '47	50 00
27	"	14 79	19 34	Sept 25 '47	28 93
	10% Overhead		1 92		21 27
			21 27		
	Pipe supplied by owner			1"	Copper outside
	Labor				

TOWN OF LEXINGTON - BOARD OF PUBLIC WORKS

**WATER DIVISION**

The undersigned applies for a supply of water at No..... St. and hereby agrees to comply with the rules and regulations as now, or at any future time, established by the Board of Selectmen.

Am't of Estimate \$.....

Owner .....


Am't Paid \$.....

Address .....

Builder .....

.....

Sketch of Service Here

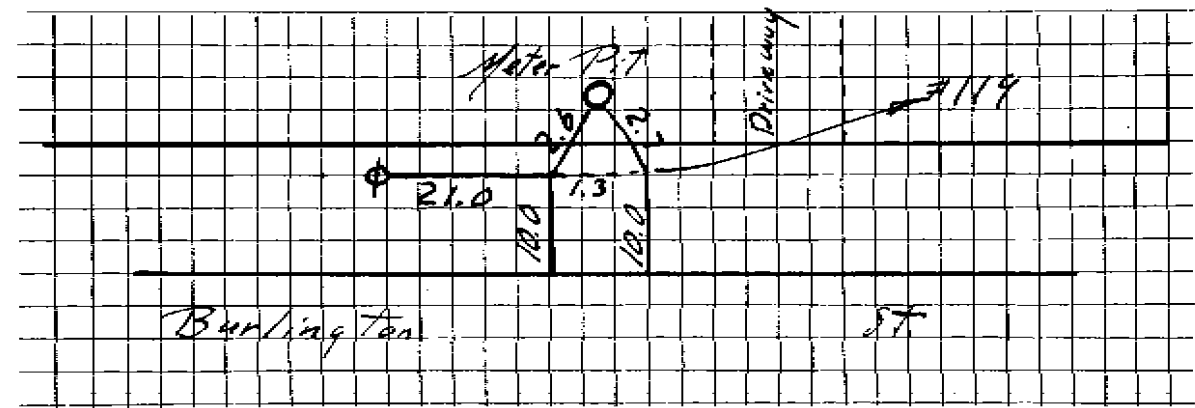

Connection made in ..... Street.

Work completed .....19

Remarks: