

WATER SERVICE RECORD

741

Name R. H. Herson

Service No. 36

Address 125 Burlington Street

Location Lexington

Repair - Renewal - New Service


COM. 4-28-52

Date	Material	Amount	Total	Date	Amount
3/21/52	Labor	6 62	6 62	3-17-52	Deposited 75 00
	10% overhead		66	4-24-52	Refunded 621 53
	42' - 3/4" copper tubing@.3439	14 44			<u>NON CHARGE</u> 533 45
	1 -3/4" C x 1/2 I.W.H. stop&waste	4 00		3/22/52	Labor 13 24
	3 hrs. Littlefield shovel	21 00			12' - 3/4" copper tubing@.3439 3 78
	1 hr. trucking	75			1 -3/4" C. corp-cock 4 33
	patching 6 x 3	6 00			1 -3/4" C x 3/4" C. curb-cock 4 37
			53 47		1 box and rod 4 52
					1-1/2 offset tail piece 50
					1-1/2 straight tail piece 50
					1 hr. littlefield shovel 7 00
					1 hr. trucking 75
					<u>39 29</u>

DATE _____

TOWN OF LEXINGTON — BOARD OF PUBLIC WORKS
WATER DIVISION

Sketch of Service Here

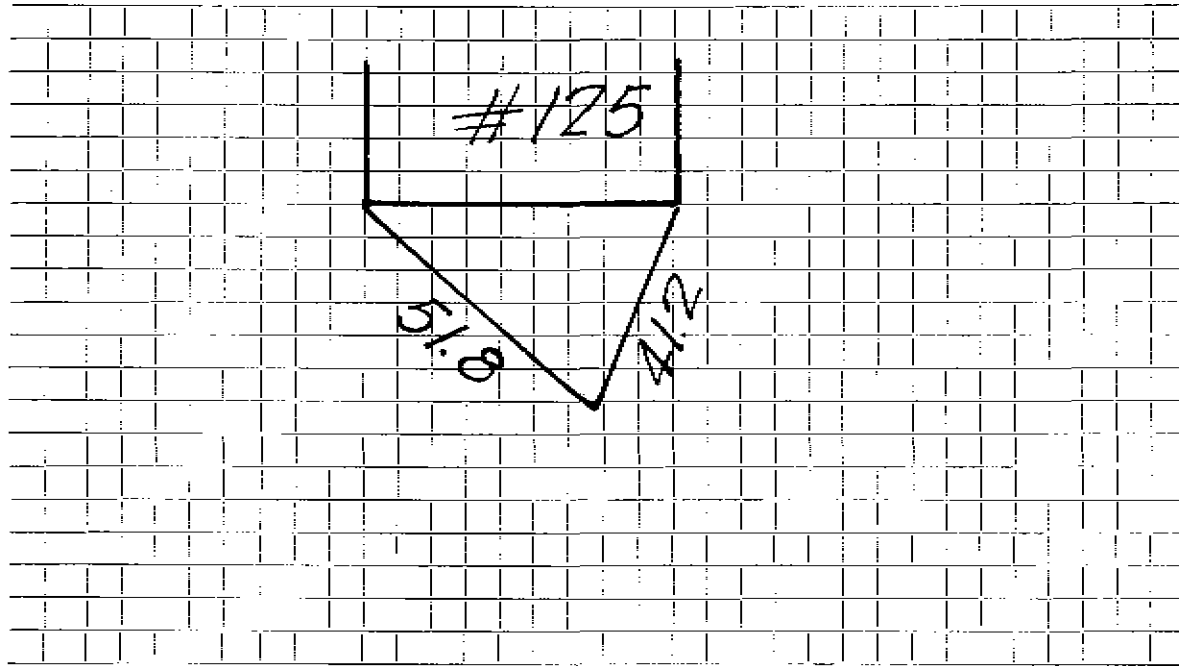

Connection made in Street. Work completed

Remarks:

.....

.....