

WATER SERVICE RECORD

Name Leeland Construction Co.

Service No. 32

Address 129 Burlington St.

Location

Reason for ~~Repair~~ - New Service

Com. 3/30/53


Date	Material	Amount	Total	Date	Amount
2/26/53	Labor	4 78		2-24-53	Deposited 50 00
	10% Overhead	48	5 26	3-31-53	Refunded ( 7 17
	48' - 3/4" Copper tubing @ .34		16 32		NON CHARGE 42 83
	1 - 3/4" C x 1/2 I.W.H. stop & waste	4 00		2/26/53	Labor 4 77
	1 1/2 hrs. Littlefield shovel @ .7	10 50			12' - 3/4" Copper tubing @ .34 4 08
	1 hr. trucking		75		1 - 3/4" C. corp-cock 4 33
	patching 6 x 3		6 00		1-3/4" C x 3/4" C. Curb-cock 4 67
			42 83		1 box and rod 3 90
					1 - 1/2 straight tail piece 50
					1 - 1/2 offset tail piece 50
					1/2 hr. Littlefield shovel 3 50
					1 hr. trucking 75
					27 00

DATE \_\_\_\_\_

TOWN OF LEXINGTON — BOARD OF PUBLIC WORKS

**WATER DIVISION**

Sketch of Service Here

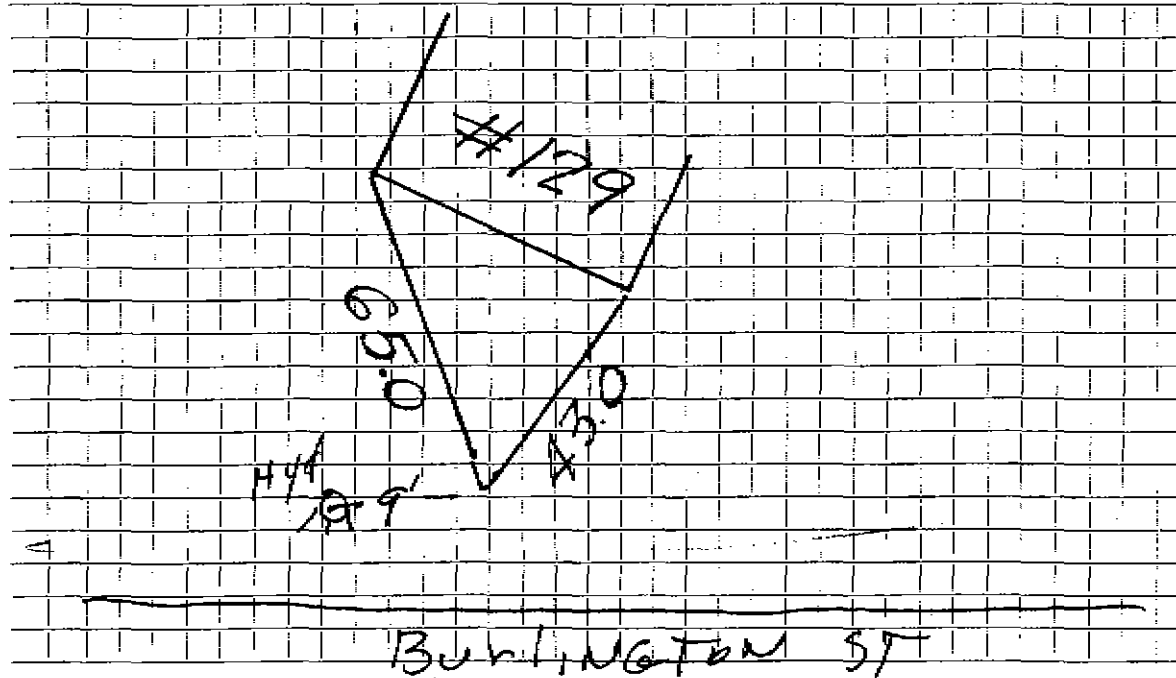

Connection made in ..... Street. Work completed .....

Remarks: .....

.....

.....