

Name A. Pike

Service No. 3298

Address 130 Burlington Street  
Lexington, Mass.

Location 130 Burlington Street

Kind of Pipe

Size

Size of Main

~~Repair-Renewal~~—New Service

Location

Date	Material	Amount	Total	Date	Amount
Jul. 11, '47	Labor	1 05	1 05	July 9, '47	15 00
	10% Overhead		11	Sept. 2, '47	2 32
	28' - 3/4" Copper Tubing @.27	7 56	7 56		12 62
	1 - 3/4" C x 1/2" I.W.F. S. & W	3 15	3 15	Jul. 11, '47	17 20
	Trucking 1 hr. @.75	75	75		4 05
			12 62	15' - 3/4" Copper Tubing @.27	4 05
				1 - 3/4" C Corp-cock	3 00
				1 - 3/4" C x 3/4" C Curb-cock	3 69
				1 - Box & Rod	4 26
				1 - 1/2" Straight Tail Piece	30
				1 - 1/2" Offset Tail Piece	30
				Trucking 1 hr. @.75	75
					33 54
	Labor				

DATE \_\_\_\_\_

# TOWN OF LEXINGTON—BOARD OF PUBLIC WORKS WATER DIVISION

The undersigned applies for a supply of water at No. \_\_\_\_\_ St. and hereby agrees to comply with the rules and regulations as now, or at any future time, established by the Board of Selectmen.

Am't. of Estimate \$ \_\_\_\_\_


Owner \_\_\_\_\_

Am't. Paid \$ \_\_\_\_\_

Address \_\_\_\_\_

Builder \_\_\_\_\_

Sketch of Service Here

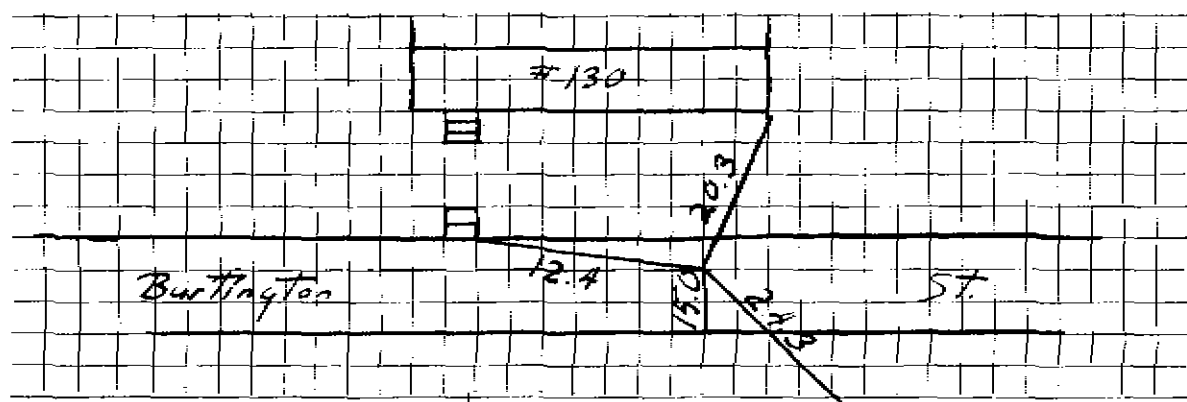

Connection made in \_\_\_\_\_ Street.

Work completed \_\_\_\_\_ 19\_\_

Remarks: