

WATER SERVICE RECORD

Name Leeland Construction Company

Service No. 34

Address 133 Burlington Street

Location

~~Repair~~ ~~Renew~~ - New Service Com. 3/30/53


Date	Material	Amount	Total	Date	Amount
2/26/53	Labor	4 78		2-24-53	50 -
	10% Overhead	48	5 26	3-30-53	(9 21
	42' - 3/4" Copper tubing @.34	14 28			NON CHARGE
	1 - 3/4" C x 1/2 I.W. H. stop & waste	4 00		2/26/53	Labor
	1 1/2 hrs. Littlefield shovel @.7	10 50			4 78
	1 hr. trucking		75		12' - 3/4" Copper tubing @.34
	Patching 6 x 3		6 00		1 - 3/4" C. corp-cock
			40 79		1 - 3/4" C x 3/4" C. curb-cock
					1 box and rod
					1 - 1/2 straight tail piece
					1 - 1/2 offset tail piece
					1/2 hrs. Littlefield shovel
					1 hr. trucking
					27 01

DATE _____

TOWN OF LEXINGTON - BOARD OF PUBLIC WORKS

WATER DIVISION

Sketch of Service Here

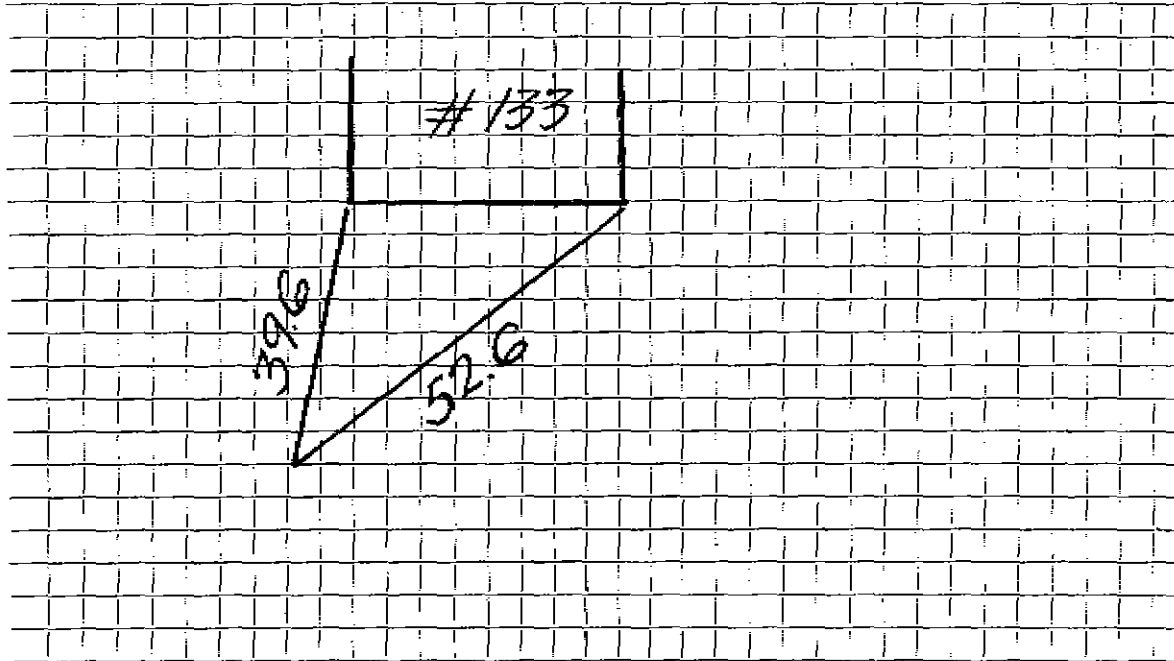

Connection made in Street. Work completed

Remarks:

.....

.....