

Name Arthur Stenberg  
Address 134 Burlington Street  
Lexington, Mass.

Service No. 289 #3874

Locatio 134 Burlington Street

Kind of Pipe

Size

Size of Main

~~Repair Work~~ - New Service

Com. 11-6-50

Location

Date	Material	Amount	Total	Date	Amount
Sept. 13, '50	Labor	14 37	14 37		
	10% Overhead		1 44		
	110' - 3/4" Copper Tubing @.275	30 25			
	1 - 3/4" C x 1/2" I.W.H. S&W	3 76			
	1 - 3/4" C x 3/4" Union (3pts)	1 61			
	Littlefield Shovel 5 hrs. @ 7.00	35 00			
	Trucking 1 hr. @.75	75			
	Patching 20 x 3		20 00		
			107 18		
				Sept. 13, '50	
				Labor	10 00
				24' - 3/4" Copper Tubing @.275	6 60
				1 - 3/4" C Corp-cock	3 60
				1 - 3/4" C x 3/4" Curb-cock	4 40
				1 - Box & Rod	3 35
				1 - 1/2" Offset Tail Piece	42
				1 - 1/2" Straight Tail Piece	42
				Littlefield Shovel 2 hrs. @ 7.00	14 00
				Trucking 1 hr. @.75	75
					<u>43 54</u>

*Sept 13 '50*

*11-6-50*

*Referred*

No Charge

*107 18*

*42 82*

Hadley Press, Inc., Lexington

DATE \_\_\_\_\_

# TOWN OF LEXINGTON—BOARD OF PUBLIC WORKS

## WATER DIVISION

The undersigned applies for a supply of water at No. \_\_\_\_\_ St. and hereby agrees to comply with the rules and regulations as now, or at any future time, established by the Board of Selectmen.

Am't. of Estimate \$ \_\_\_\_\_


Owner \_\_\_\_\_

Am't. Paid \$ \_\_\_\_\_

Address \_\_\_\_\_

Builder \_\_\_\_\_

Sketch of Service Here

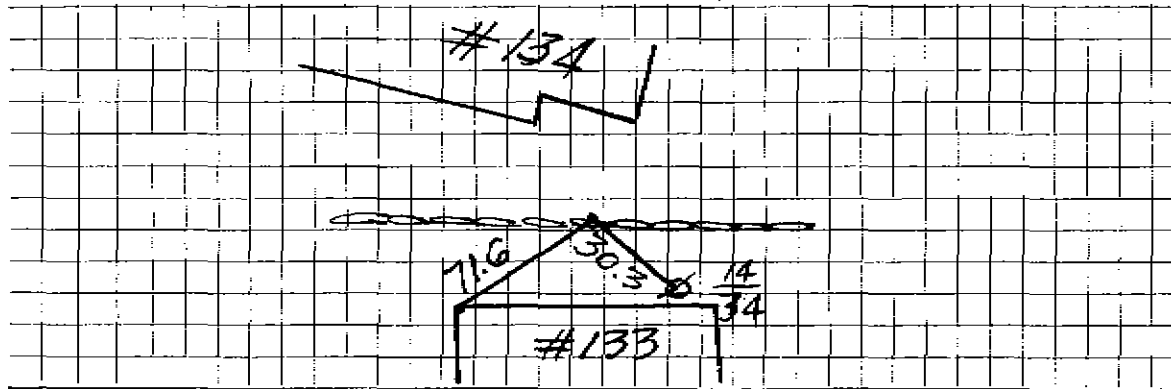

Connection made in \_\_\_\_\_ Street.

Work completed \_\_\_\_\_ 19

Remarks: