




DATE 5-18-01

TOWN OF LEXINGTON — BOARD OF PUBLIC WORKS  
**WATER DIVISION**

Sketch of Service Here  
137 BURLINGTON ST

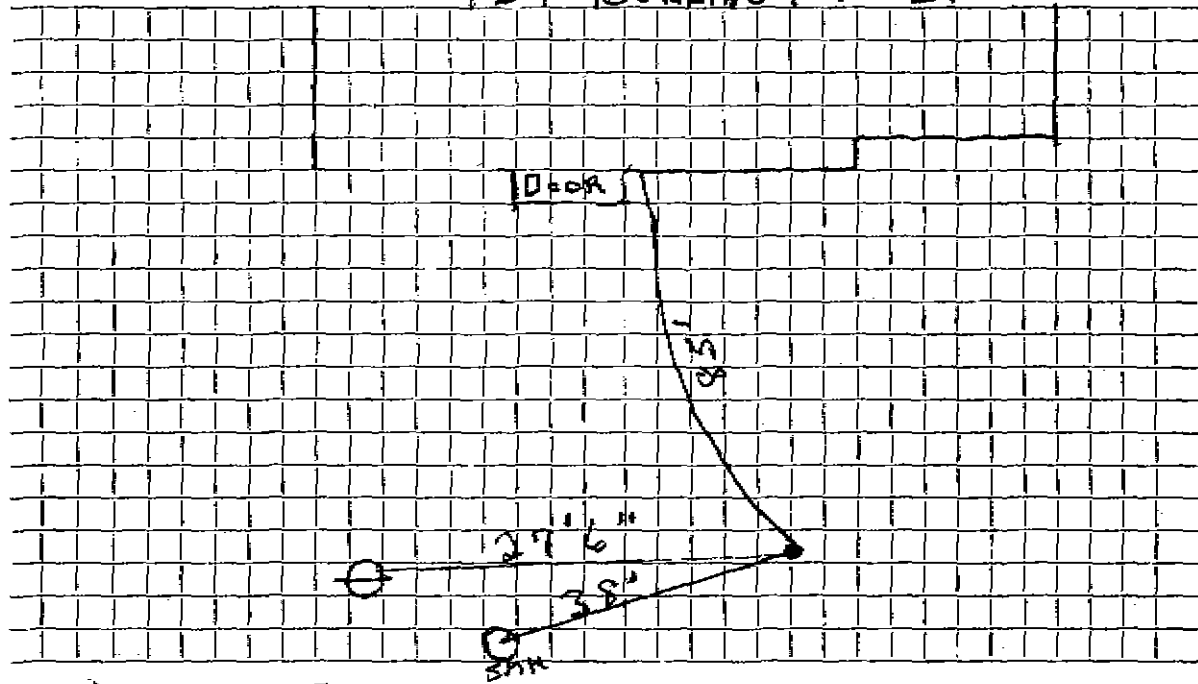

Connection made in ... BURLINGTON ... Street. Work completed .....

Remarks: .....  
.....  
.....