

Name Swend Nielsen
 Address 138 Burlington Street
 Lexington, Mass.

Service No. 27

Location 138 Burlington Street

Kind of Pipe
 Size
 Size of Main
 Location
~~XXXX-XXXX~~—New Service Com. 5-2-49

Date	Material	Amount	Total	Date	Amount
March, 29, '49	Labor	2 30	2 30	Mar 24 '49	70 00
	10% Overhead		23	May 1 '49	1 11
	146' - 3/4" Copper Tubing @.27	39 42	42		<u>65 16</u>
	1 - 3/4" C x 1/2" I.W.H. S&W	3 29	29	March 29, '49	25 37
	3 - 3/4" C x 3/4" C Union(3pts)	4 17	17	18' - 3/4" Copper Tubing @.27	4 86
	Trucking 1 hr. @.75		75	1 - 3/4" C Corp-cock	3 15
	Patching 15 x 3		15 00	1 - 3/4" C x 3/4" C Curb-cock	3 85
			65 16	1 - Box & Rod	3 95
				1 - 1/2" Straight Tail Piece	37
				1 - 1/2" Offset Tail Piece	37
				Trucking 1 hr. @.75	75
					<u>42 67</u>
	Labor			2/14/62	
				Broken CONT	
				1 3/4 Curb	
				1 3/4 Union 3 PART	
				3' COPPER	

TOWN OF LEXINGTON - BOARD OF PUBLIC WORKS

WATER DIVISION

The undersigned applies for a supply of water at No. St. and hereby agrees to comply with the rules and regulations as now, or at any future time, established by the Board of Selectmen.

Am't of Estimate \$.....


Owner

Am't Paid \$.....

Address

Builder

.....

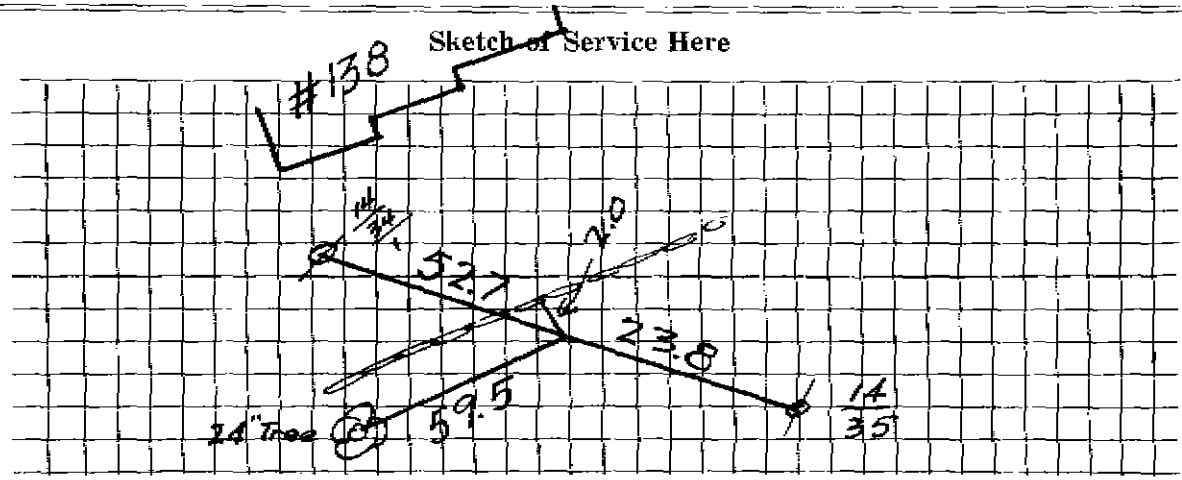

Connection made in Street.

Work completed19

Remarks: