

WATER SERVICE RECORD

Name Theodore G. Holcombe

Service No. 55

Address 145 Eurlington Street

Location Lexington

Repair ~~Renewal~~ - New Service

Com. 6-16-52


Date	Material	Amount	Total	Date	Amount
5/2/52	Labor	7 98		4-16-52 Deposited	75 00
	10% overhead	80	8 78	6-16-52 Refunded	10 00
	60' - 3/4" copper tubing @ .3439	20 63			5 16
	1 - 3/4" C x 1/2 I.W.H. stop & waste	4 00		NON CHARGE	
	2 hrs. Littlefield shovel	14 00		5/2/52 Labor	7 99
	1 hr. trucking	75		14' - 3/4" copper tubing @ .3439	4 81
	patching 8 x 3	8 00		1 - 3/4" C. corp-cock	4 33
			56 16	1 - 3/4" C x 3/4" C. curb-cock	4 67
				1 - box and rod	4 52
				1 - 1/2 offset tail piece	50
				1 - 1/2 straight tail piece	50
				1 hr. Littlefield shovel	7 00
				1 hr. trucking	75
					<u>35 07</u>

DATE _____

TOWN OF LEXINGTON — BOARD OF PUBLIC WORKS

WATER DIVISION

Sketch of Service Here

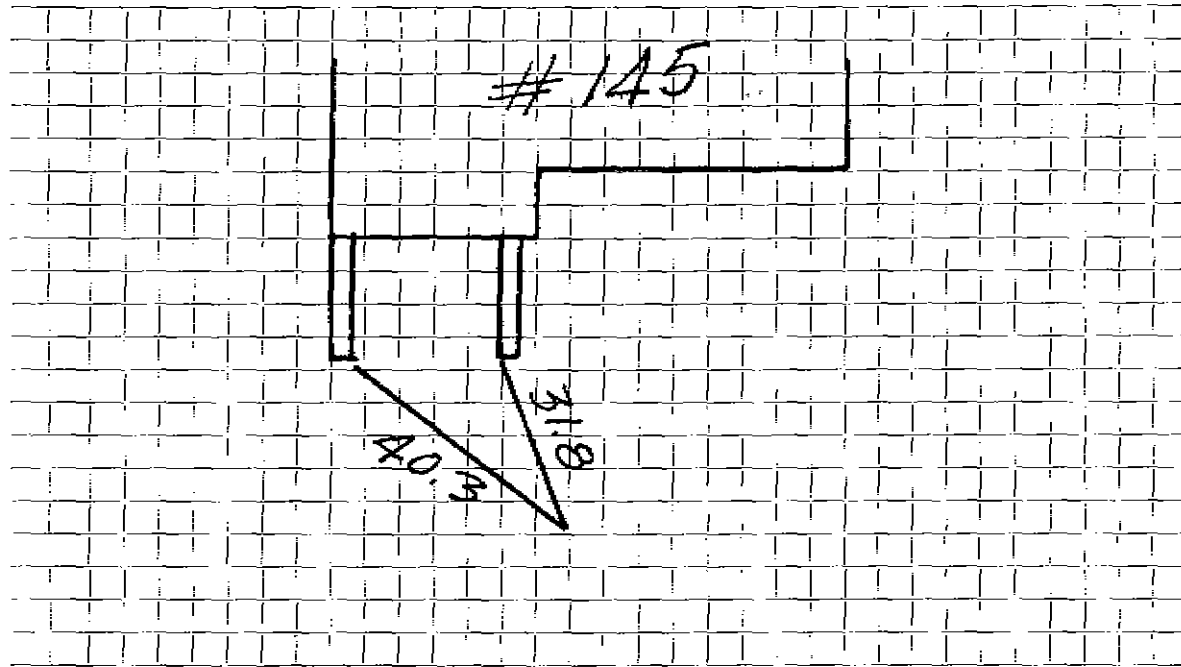

Connection made in Street. Work completed

Remarks:

.....

.....