

Name Robert Moulton
 Address 146 Burlington Street
 Lexington, Mass.

Service No. #2115
 #5076

Location 146 Burlington Street

Kind of Pipe Size Size of Main
~~Repair~~ ~~Renewal~~ - New Service Com. 8-23-48 Location

Date	Material	Amount	Total	Date	Location	Amount
Jul. 16, '48	Labor	2 20	2 20	July 2, '48	Deposited	40 00
	10% Overhead		22			
	90' - 3/4" Copper Tubing @.255		22 95		Non-Charge	
	1 - 3/4" C x 1/2" I.W.H. S & W		3 15	July 16, '48	Labor	4 40
	1 - 3/4" C x 3/4" C Union (Bots)		1 32	17' - 3/4" Copper Tubing @.255		4 34
	Trucking 1 hr. @.75		75	1 - 3/4" C Corp-cock		3 00
	Patching 9 x 3		9 00	1 - 3/4" C x 3/4" C Curb-cock		3 68
			39 59	1 - Box & Rod		3 55
	<i>No repair done here</i>			1 - 1/2" Offset Tail Piece		30
	trench dug by owner.			1 - 1/2" Straight Tail Piece		30
	Labor			Littlefield Shovel 2 hrs. @ 7.00		14 00
				Trucking 1 hr. @.75		75
						34 32

Hadley Press, Inc., Lexington

TOWN OF LEXINGTON—BOARD OF PUBLIC WORKS WATER DIVISION

The undersigned applies for a supply of water at No. _____ St. and hereby agrees to comply with the rules and regulations as now, or at any future time, established by the Board of Selectmen.

Am't. of Estimate \$ _____

Owner _____


Am't. Paid \$ _____

Address _____

Builder _____

20 Greenway Hill Dr. Lexington

Sketch of Service Here

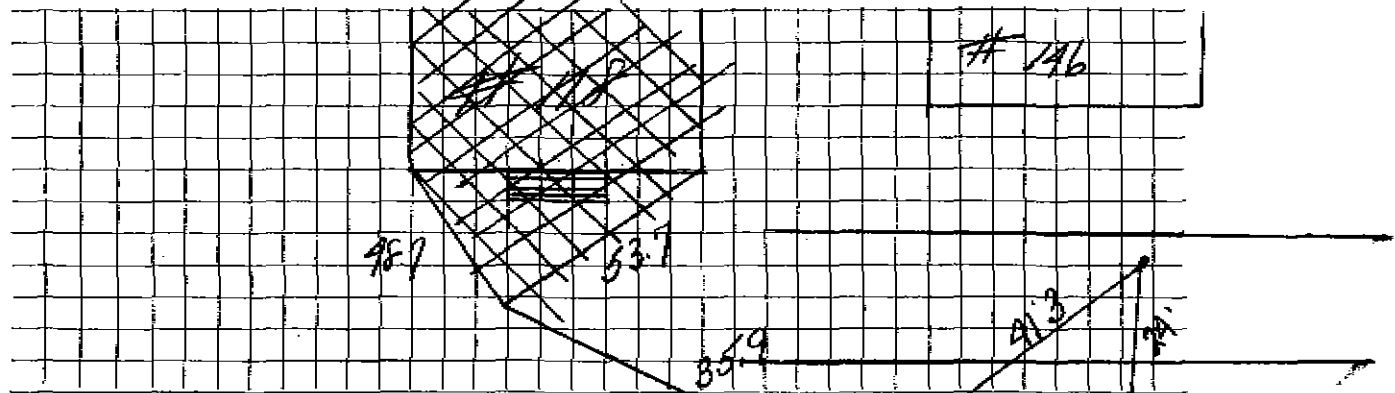

Connection made in _____ Street. Work completed _____ 19

Remarks: