

Name William J. Blanchard

Service No. 97

Address 149 Burlington Street

Lexington, Mass.

Locatio 149 Burlington Street

Kind of Pipe

Size

Size of Main

~~Repair~~ Renewal - New Service

Com. 9-5-50

Location

Date	Material	Amount	Total	Date	Amount	
June 6, '50	Labor	10 10	10 10	May 16 '50	90 00	
	10% Overhead		1 01		<del>2 01</del>	
	70' - 1" Copper Tubing @.284		19 88		64 03	
	1 - 3/4" C x 1/2" I.W.H. S&W		3 29	June 6, '50	Labor	5 00
	Littlefield Shovel 3 hrs. @7.00	21 00	21 00	20' - 1" Copper Tubing @.284	5 68	
	Trucking 1 hr. @.75		75	1 - 3/4" C Corp-cock	3 15	
	Patching 8 x 3		8 00	1 - 3/4" C x 3/4" C Curb-cock	3 85	
			64 03	1 - Box & Rod	3 35	
				1 - 1/2" Offset Tail Piece	38	
				1 - 1/2" Straight Tail Piece	38	
				Littlefield Shovel 1 hr. @ 7.00	7 00	
				Trucking 1 hr. @.75	75	
	Labor				29 54	

Hadley Press, Inc., Lexington

DATE \_\_\_\_\_

# TOWN OF LEXINGTON—BOARD OF PUBLIC WORKS

## WATER DIVISION

The undersigned applies for a supply of water at No. \_\_\_\_\_ St. and hereby agrees to comply with the rules and regulations as now, or at any future time, established by the Board of Selectmen.

Am't. of Estimate \$ \_\_\_\_\_


Owner \_\_\_\_\_

Am't. Paid \$ \_\_\_\_\_

Address \_\_\_\_\_

Builder \_\_\_\_\_

Sketch of Service Here

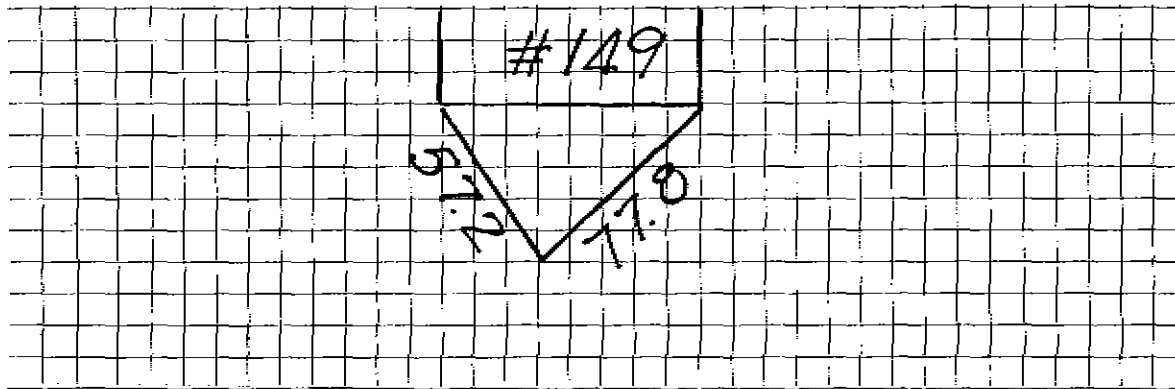

Connection made in \_\_\_\_\_ Street.

Work completed \_\_\_\_\_ 19

Remarks: