

Name N. P. Neilsen
 Address 152 Burlington Street
 Lexington, Mass.

Service No. ⁰² 3341
 #6607

Location 152 Burlington Street

Kind of Pipe Size Size of Main Location
~~Repair/Replacement~~ New Service

Date	Material	Amount	Total	Date	Location	Amount
Aug. 14, '47	Labor	2 10	2 10	Aug 8 '47	Deposited	75 00
	10% Overhead		21	Sept 23 '47	Refunded	3 55
	170' - 3/4" Copper Tubing @.28	47 60			Non-Charge	71 45
	1 - 3/4" C x 1/2" I.W.F. S & W	3 15		Aug. 13, '47	Labor	7 60
	2 - 3/4" C x 3/4" Union (3pts)	2 64		14	"	16 47
	Patching 15 x 3		15 00	24' - 3/4" Copper Tubing @.28		6 72
	Trucking 1 hr. @.75		75	1 - 3/4" C Corp-cock		3 00
			71 45	1 - 3/4" C x 3/4" C Curb-cock		3 68
				1 - Box & Rod		4 26
				1 - 2" Straight Tail Piece		30
				1 - 1/2" Offset Tail Piece		30
				Trucking 1 hr. @.75		75
	Labor					43 08

TOWN OF LEXINGTON – BOARD OF PUBLIC WORKS

WATER DIVISION

The undersigned applies for a supply of water at No..... St. and hereby agrees to comply with the rules and regulations as now, or at any future time, established by the Board of Selectmen.

Am't of Estimate \$.....


Owner

Am't Paid \$.....

Address

Builder

Sketch of Service Here

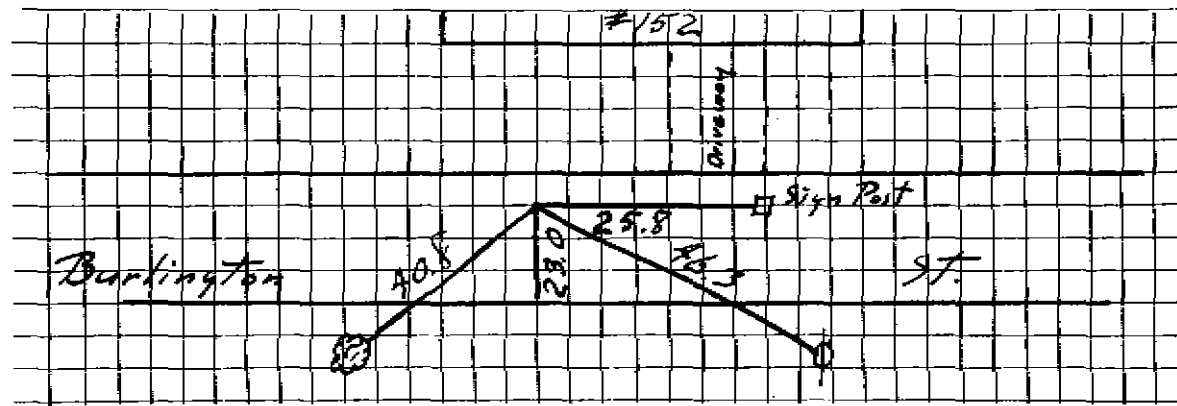

Connection made in Street. Work completed19

Remarks: