

Name Lexington Const. Co.

Service No. 247

#5707

Address 155 Burlington Street

Lexington, Mass.

Location 155 Burlington Street

Kind of Pipe

Size

Size of Main

~~Repair~~ ~~Renewal~~ New Service

Com. 12-13-49

Location

Date	Material	Amount	Total	Date	Amount	
Nov. 23, '49	Labor	3 00	3 00	Nov. 16 '49	Deposited	50 00
	10% Overhead		30	Dec. 22 '49	Refunded	6 25
	60' - 3/4" Copper Tubing @ .24	14 40	14 40		No Charge	43 74
	1 - 3/4" C x 1/2" I.W.H. S&W	3 29	3 29	Nov. 23, '49	Labor	4 20
	Littlefield Shovel 2 hrs. @ 7.00	14 00	14 00	11' - 3/4" Copper Tubing @ .24		2 64
	Trucking 1 hr. @ .75		75	1 - 3/4" C Corp-cock		3 15
	Patching 8 x 3		8 00	1 - 3/4" C x 3/4" C Curb-cock		3 85
			43 74	1 - Box & Rod		3 75
				1 - 1/2" Offset Tail Piece		37
				1 - 1/2" Straight Tail Piece		37
				Littlefield Shovel 1 hr. @ 7.00		7 00
				Trucking 1 hr. @ .75		75
	Labor					26 08

TOWN OF LEXINGTON - BOARD OF PUBLIC WORKS

**WATER DIVISION**

The undersigned applies for a supply of water at No..... St. and hereby agrees to comply with the rules and regulations as now, or at any future time, established by the Board of Selectmen.

Am't of Estimate \$.....

Owner .....


Am't Paid \$.....

Address .....

Builder .....

.....

Sketch of Service Here

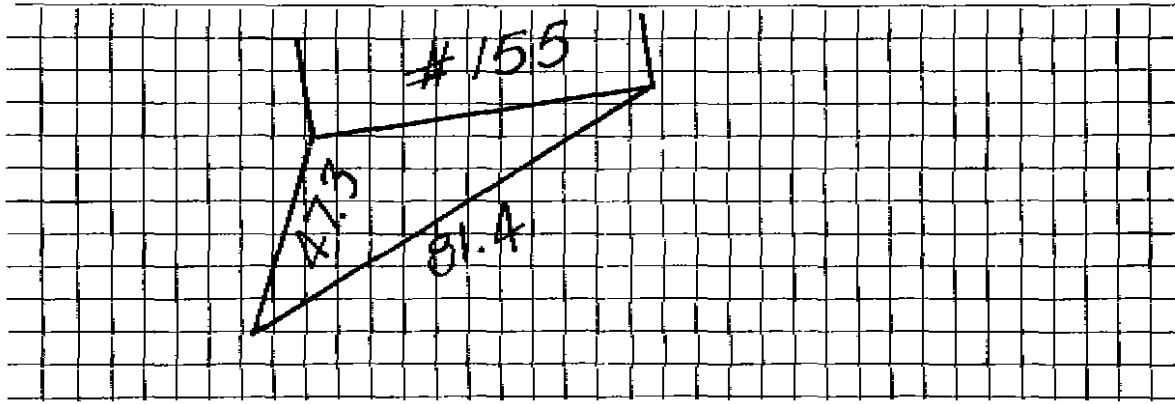

Connection made in ..... Street.

Work completed .....19

Remarks: