

Name Svend H. Nielsen

Service No. 180 3420

Address 158 Burlington Street

Location 158 Burlington Street

Kind of Pipe

Size

Size of Main

~~Change Order~~—New Service

Com. 12/31/47

Location

Date	Material	Amount	Total	Date		Amount
12/5/47	Labor	1 30	1 30	12/4/47	Deposited	25 00
	10% Overhead		13	12/31/47	Refunded	3 17
	25' 3/4" Cop. Tubing @ .26		6 50			<hr/> 21 83
	1 3/4" C x 1/2" I.W.H S&W		3 15		Non-Charge	
	1 hr. Trucking		75	12/5/47	Labor	3 83
	Patching 10x3		10 00		24' 3/4" C. Tubing @ .26	6 24
			<hr/> 21 83		1 3/4" C. Corp. Cock	3 00
					1 3/4" C. x 3/4" Curb. Cock	3 68
					1 Box and Mod	4 26
					1 1/2 Hr. hired Shovel	10 50
					1 hr. Trucking	75
					1 1/2" offset Tailpeice	30
					1 1/2" Str. Tailpeice	30
	Labor					<hr/> 32 86

TOWN OF LEXINGTON - BOARD OF PUBLIC WORKS

WATER DIVISION

The undersigned applies for a supply of water at No..... St. and hereby agrees to comply with the rules and regulations as now, or at any future time, established by the Board of Selectmen.

Am't of Estimate \$.....

Owner


Am't Paid \$.....

Address

Builder

10 1/2" Water Mains

Sketch of Service Here

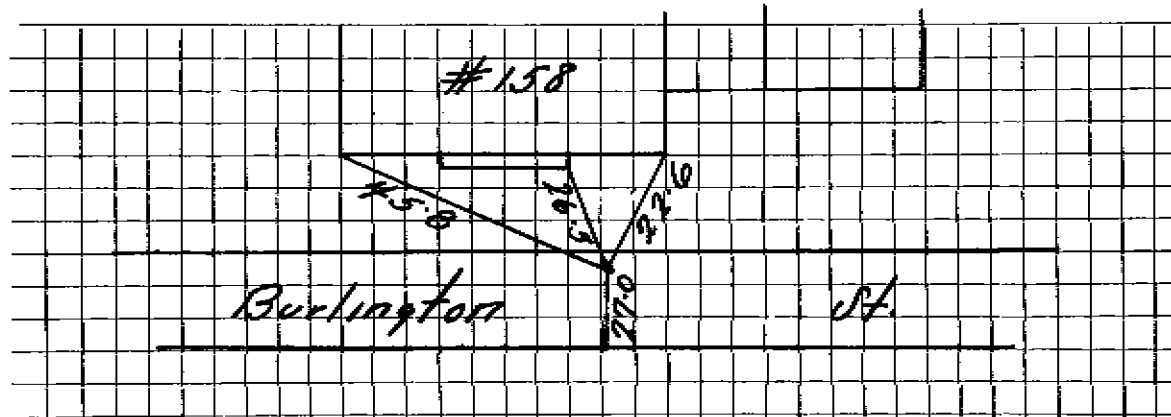

Connection made in Street.

Work completed19

Remarks: