

Name Ingmann Nielsen
 Address 159 Burlington Street
 Lexington, Mass.

Service No. 36
 # 3896

Location 159 Burlington Street

Kind of Pipe
 Size
 Size of Main
 Location
~~Repair~~ New Service Com. 5-2-49

Date	Material	Amount	Total	Date	Amount
Mar. 26, '49	Labor	4 30	4 30	Mar. 21, '49	50 00
	10% Overhead		43	May 5, '49	5 97
	98' - 3/4" Copper Tubing @.27	26 46	26 46		44 01
	1 - 3/4" C x 1/2" I.W.H. S&W	3 29	3 29	Mar. 26, '49	4 35
	2 - 3/4" C x 3/4" C Union 3 pts	2 78	2 78	9' - 3/4" Copper Tubing @.27	2 43
	Trucking 1 hr. @.75	75	75	1 - 3/4" C Corp-cock	3 15
	Patching 6 x 3	6 00	6 00	1 - 3/4" C x 3/4" C Curb-cock	3 85
			44 01	1 - Box & Rod	3 95
				1 - 1/2" Offset Tail Piece	37
				1 - 1/2" Straight Tail Piece	37
				Littlefield Shovel 2 hrs. @7.00	14 00
				Trucking 1 hr. @.75	75
	Labor				33 22

TOWN OF LEXINGTON - BOARD OF PUBLIC WORKS

WATER DIVISION

The undersigned applies for a supply of water at No. St. and hereby agrees to comply with the rules and regulations as now, or at any future time, established by the Board of Selectmen.

Am't of Estimate \$.....

Owner


Am't Paid \$.....

Address

Builder

.....

Sketch of Service Here

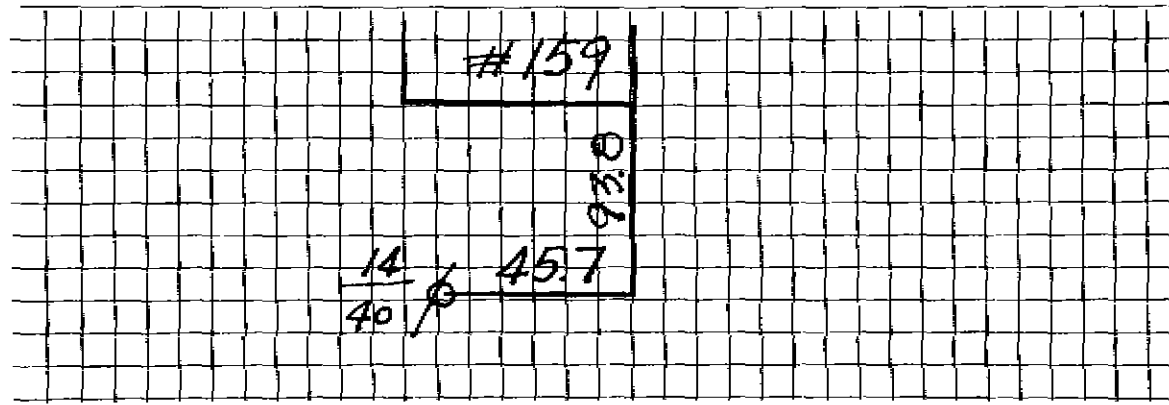

Connection made in Street.

Work completed19

Remarks: