

WATER SERVICE RECORD

Name

Service No.

Address # 16 BURLINGTON

Location LEXINGTON

Repair—Renewal—New Service Water Main Replacement


Date	Material	Amount	Total	Date	Amount
9/16 92	OUTSIDE 19' LF 1" COPPER 1" CORP. 1" C/C CW/BOX 3/4" x 1" REDUCER	UNION			
				12-1-49	Inside Labor 1 35
					10% O.H. 14
					71' 1" Copper Tubing @ .31 22 01
					1 1" x 1" END STD 4 23
					1 1" x 1" C 3pt Union 1 83
					1 Hr Trucking 75
					<u>30 31</u>

DATE 9/16/92

TOWN OF LEXINGTON — BOARD OF PUBLIC WORKS

WATER DIVISION

Sketch of Service Here

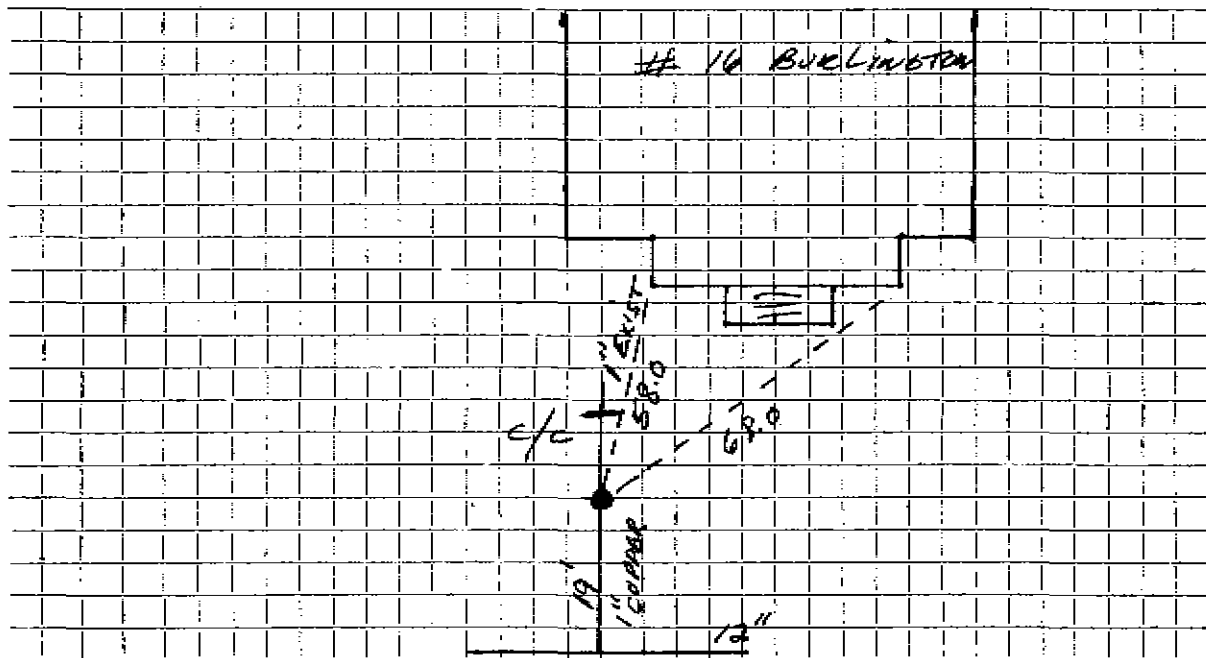

Connection made in # 16 BURLINGTON Street. Work completed

Remarks: PART OF CONTRACT # 91-10 "WATER MAIN REPLACE"

..... INSTALLED BY: CJB