

Name Charles D. Hufton

Service No.

5060

Address 162 Burlington Street
Lexington, Mass.

Location 162 Burlington Street

Kind of Pipe

Size

Size of Main

~~Repair~~ ~~Renewal~~ ~~New Service~~

Location

| Date | Material | Amount | Total | Date | Amount |
|---------------|-----------------------------------|--------|-------|---------------------------------|--------|
| Sept. 16, '48 | Labor | 1 25 | 1 25 | Sept 16 '48 | 50 00 |
| | 100 Overhead | | 23 | Oct 28 '48 | 3 20 |
| | 108' - 3/4" Copper Tubing @ .255 | 27 54 | | | 46 74 |
| | 1 - 3/4" C x 1/2" I.W.S. S & V | 3 15 | | | |
| | 1 - 3/4" C x 3/4" 3 Union (3 pts) | 1 32 | | Sept. 16, '48 | 27 63 |
| | Trucking 1 hr. @ .75 | 75 | | 25' - 3/4" Copper Tubing @ .255 | 6 38 |
| | Patching 12 x 3 | 12 00 | | 1 - 3/4" C Woro-cock | 3 00 |
| | | | 16 14 | 1 - 3/4" C x 2/4" C Woro-cock | 3 68 |
| | | | | 1 - Box & Rod | 3 55 |
| | | | | 1 - 1/2" Offset Tail Piece | 30 |
| | | | | 1 - 1/2" Straight Tail Piece | 30 |
| | | | | Trucking 1 hr. @ .75 | 75 |
| | | | | | 45 59 |

Com. 10/20/48

trench dug by owner.

Labor

Deposited
Refund
Non-Charge

Hadley Press, Inc., Lexington

TOWN OF LEXINGTON—BOARD OF PUBLIC WORKS

WATER DIVISION

The undersigned applies for a supply of water at No. _____ St. and hereby agrees to comply with the rules and regulations as now, or at any future time, established by the Board of Selectmen.

Am't. of Estimate \$ _____


Owner _____

Am't. Paid \$ _____

Address _____

Builder _____

Sketch of Service Here

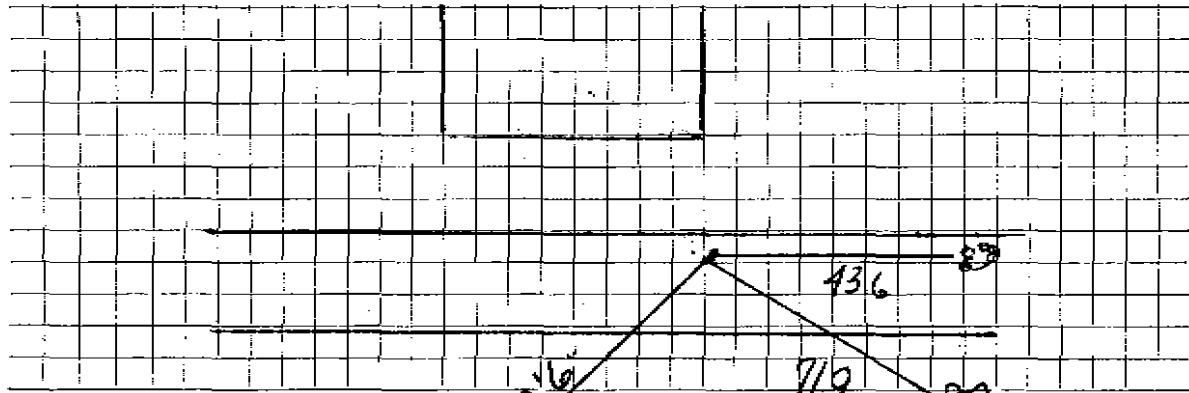

Connection made in _____

Street.

Work completed _____

Remarks: