

Name Neils P. Neilson  
 Address 163 Burlington Street  
 Lexington, Mass.

Service No. 166

# 5752

Location 163 Burlington Street

Kind of Pipe

Size

Size of Main

~~Repair~~ ~~Renewal~~ - New Service

Com. 9-26-49

Location

Date	Material	Amount	Total	Date	Material	Amount
Aug. 19, '49	Labor	1 25	1 24	Aug 16 49	Deposited	80 00
	10% Overhead		13	Aug 16 49	Refunded	4 71
	77' - 3/4" Copper Tubing @ .24	18 48			No Charge	30 29
	1 - 3/4" C x 1/2" I.W.H. S&W	3 29		Aug. 19, '49	Labor	4 48
	1 - 3/4" C x 3/4" C Union (3pts)	1 39			10' @ 3/4" Copper tubing @ .24	2 40
	Trucking 1 hr. @ .75		75		1 - 3/4" Corp-cock	3 15
	Patching 5 x 3		5 00		1 - 3/4" C x 3/4" C Curb-cock	3 85
			30 29		1 - Box & Rod	3 75
					1 - 1/2" Offset Tail Piece	37
					1 - 1/2" Straight Tail Piece	37
					Littlefield Shovel 2 1/2 hrs.	17 50
					Trucking 1 hr. @ .75	75
	Labor					36 62

DATE \_\_\_\_\_

TOWN OF LEXINGTON - BOARD OF PUBLIC WORKS

**WATER DIVISION**

The undersigned applies for a supply of water at No..... St. and hereby agrees to comply with the rules and regulations as now, or at any future time, established by the Board of Selectmen.

Am't of Estimate \$.....

Owner .....


Am't Paid \$.....

Address .....

Builder .....

.....

Sketch of Service Here

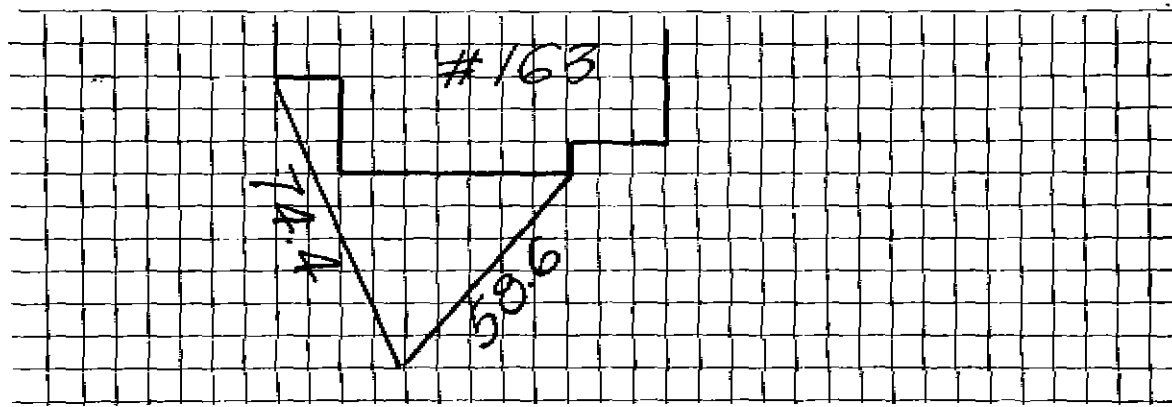

Connection made in ..... Street.

Work completed .....19

Remarks: