

Name H. L. Barker

Service No. 303 # 984

Address 167 Burlington Street

Lexington, Mass.

Location 167 Burlington Street

Kind of Pipe

Size

Size of Main

~~Repair/Rehaul~~ - New Service

Com. 12-5-49

Location

Date	Material	Amount	Total	Date	Amount
Nov. 10, '49	Labor	2 40	2 40	Oct 28 '49	40 00
	10% Overhead		24	Dec. 22 '44	9 09
	66' - 3/4" Copper Tubing @ .24	15 84	15 84		<u>30 91</u>
	1 - 3/4" C x 3/8" I.W.H. S&W	3 29	3 29		2 40
	1 - 3/4" C x 3/4" C Union (3pts)	1 39	1 39	Nov. 10, '49	Labor
	Trucking 1 hr. @ .75	.75	.75	9' - 3/4" Copper Tubing @ .24	2 16
	Patching 7 x 3	7 00	7 00	1 - 3/4" C Corp-cock	3 15
			30 91	1 - 3/4" C x 3/4" C Gurb-cock	3 85
				1 - Box & Rod	3 75
				1 - 1/8" Offset Tail Piece	37
				1 - 1/8" Straight Tail Piece	37
				Littlefield Shovel 2 hrs. @ 7.00	14 00
				Trucking 1 hr. @ .75	75
	<b>Labor</b>				<u>30 80</u>

*Reported*  
*Refunded*  
No Charge

DATE \_\_\_\_\_

TOWN OF LEXINGTON – BOARD OF PUBLIC WORKS  
**WATER DIVISION**

The undersigned applies for a supply of water at No..... St. and hereby agrees to comply with the rules and regulations as now, or at any future time, established by the Board of Selectmen.

Am't of Estimate \$.....

Owner .....


Am't Paid \$.....

Address .....

Builder .....

.....

Sketch of Service Here

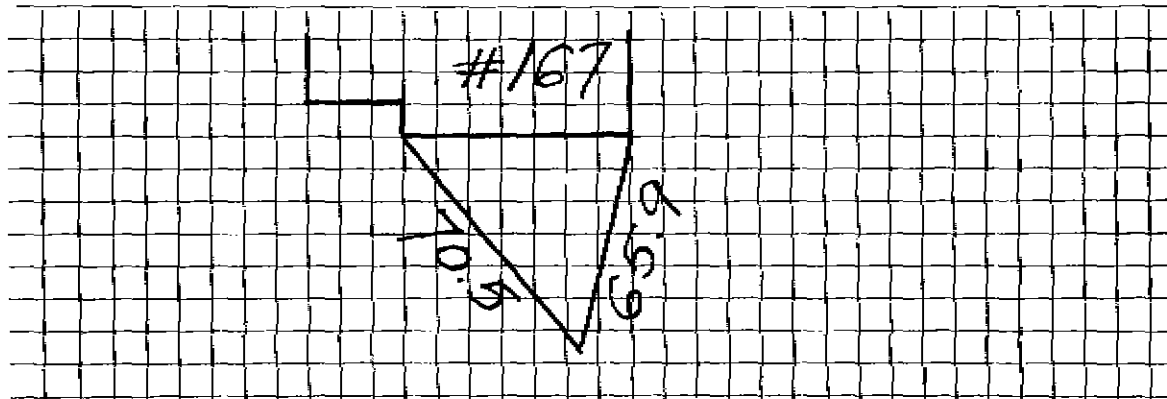

Connection made in ..... Street.

Work completed .....19

Remarks: